


T.26S.R.8W.W.M.

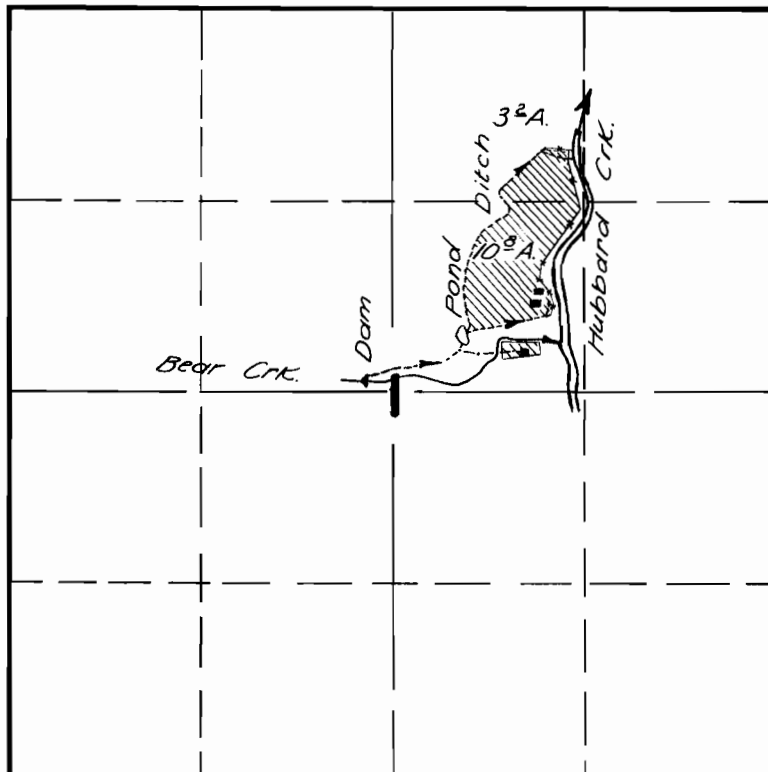

FINAL PROOF SURVEY
UNDER

Application No. 21337... Permit No. 16730...
IN NAME OF

.....**WESLEY M. GRIER**.....

Surveyed MAY 18, 1950, by H.L. COFFMAN