


K-2183
72422

T. 40 S., R. 14 1/2 E., W.M.

E. Br. Lost River Mtn.

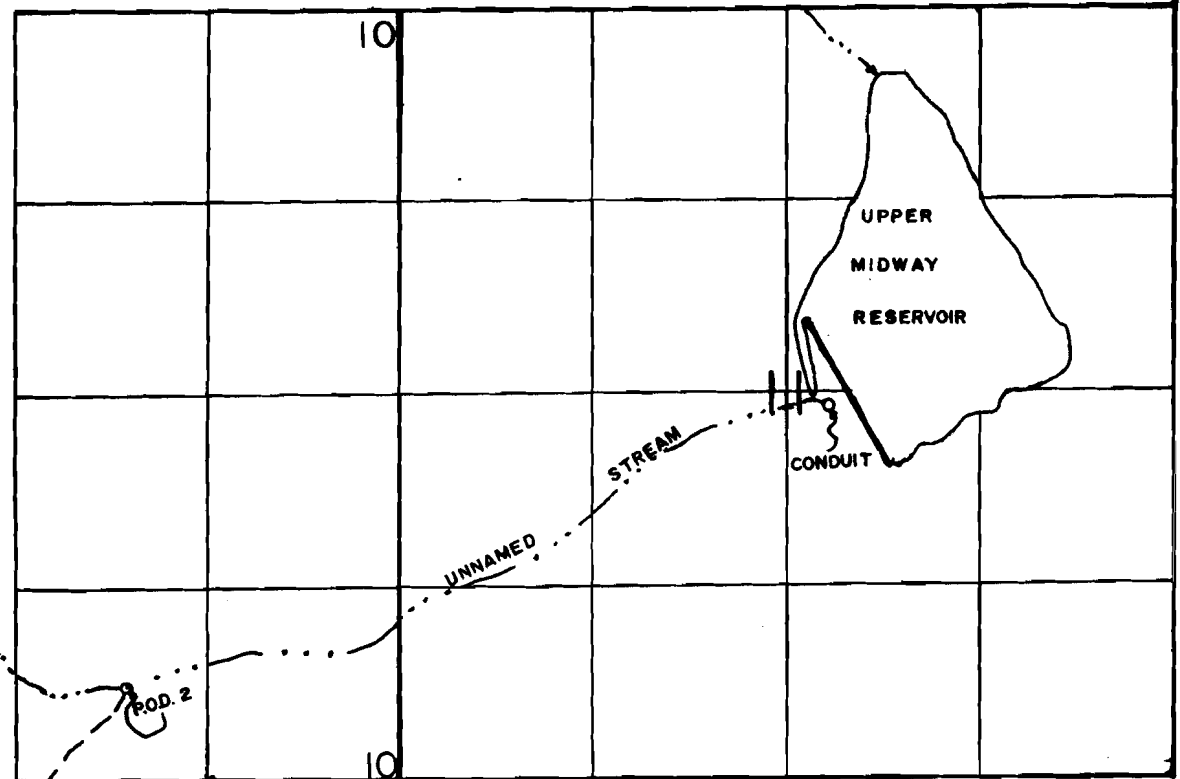

SCALE: 1"=1320'

FINAL PROOF SURVEY
UNDER

Application No. R-32559 Permit No. R-2183
IN NAME OF

U.S. DEPARTMENT OF INTERIOR B.L.M.

Surveyed AUG 2, 1994, by R.M.SUTTERFIELD