


20727
72423

T. 40 S., R. 14 1/2 E., W.M.

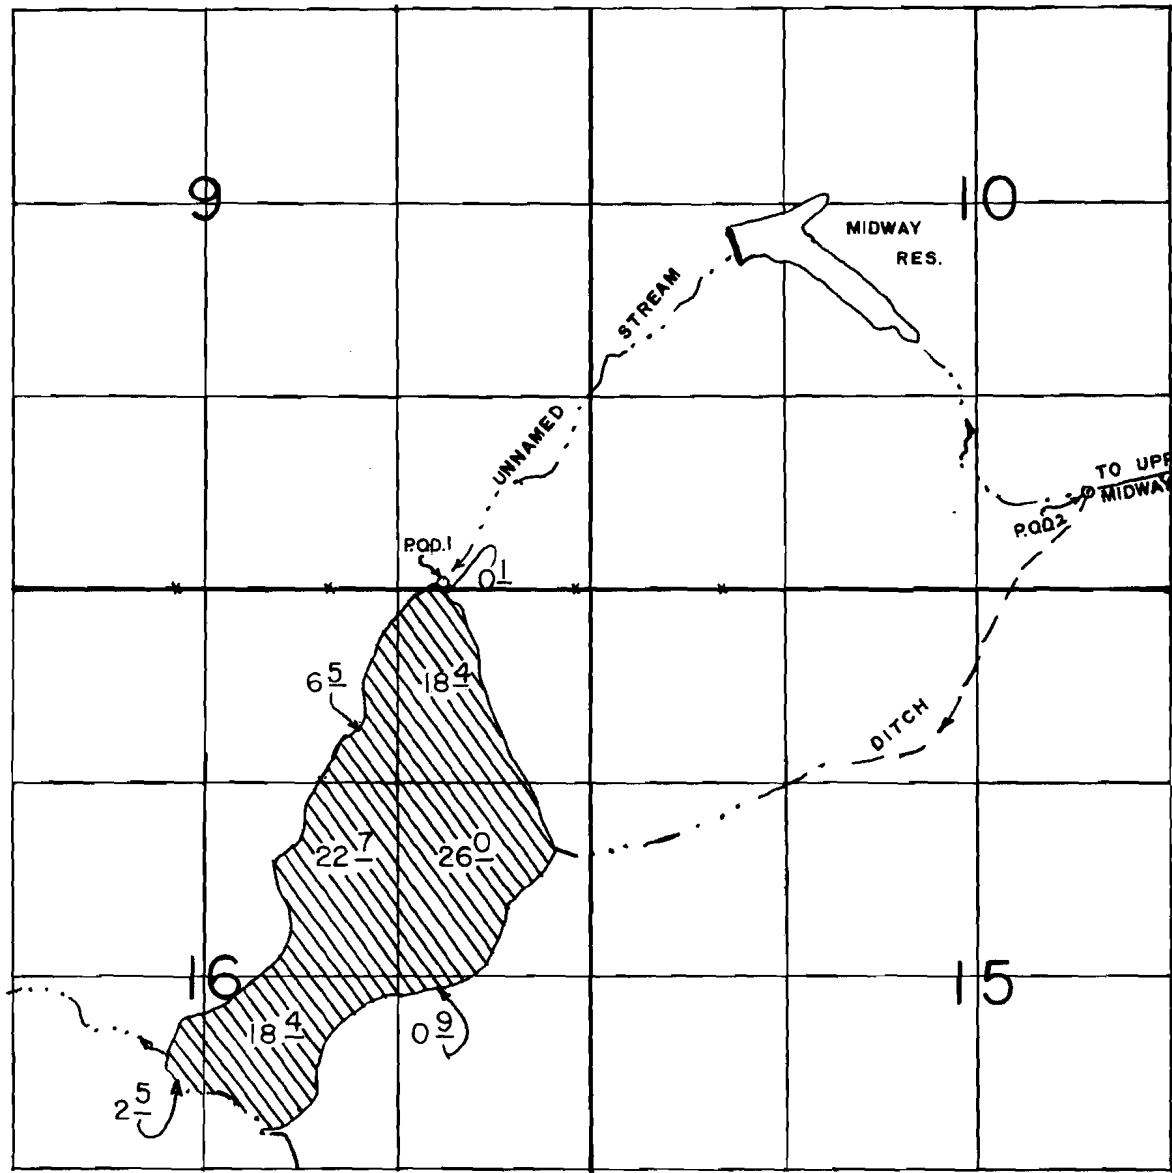

P.O.D. 1, LOC: 50' N & 1000' W FROM SE COR. OF SEC 9.
P.O.D. 2, LOC: 650' N & 3390' E FROM SW COR. OF SEC 10.

SCALE: 1" = 1320'

FINAL PROOF SURVEY

UNDER

Application No. 32560 Permit No. 25759
IN NAME OF

96.5 ac

U.S. DEPARTMENT OF INTERIOR B.L.M.

Surveyed AUG 2, 1994, by R.M. SUTTERFIELD

E. Br. Lost River Mine