


K-2182
72424

T. 40 S., R. 14 1/2 E., W.M.

E. Br. Lost River Mtn.

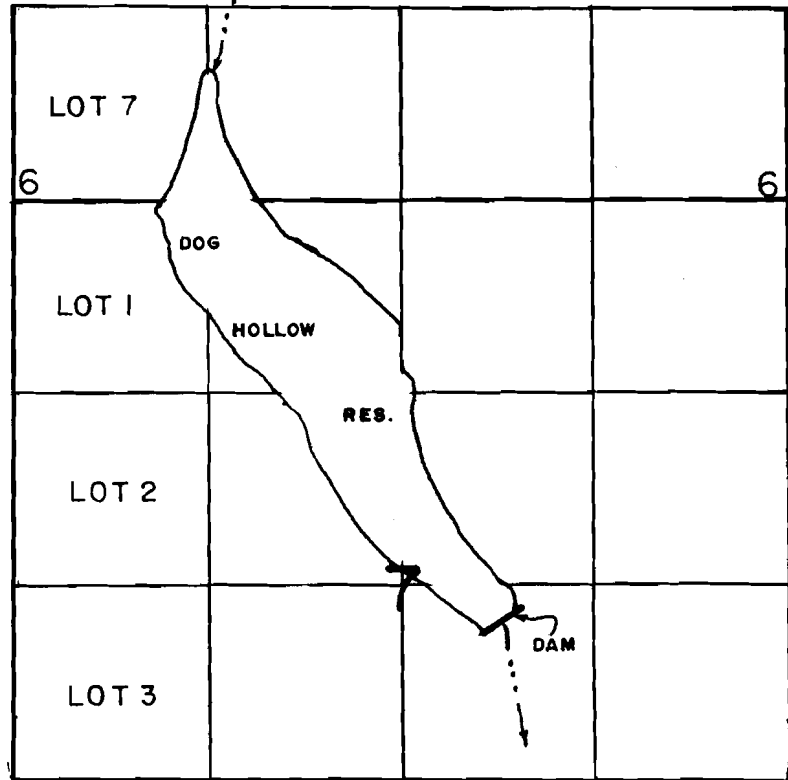

SCALE: 1" = 1320'

FINAL PROOF SURVEY

UNDER

Application No. R-32561 Permit No. R-2182
IN NAME OF

U.S. DEPARTMENT OF INTERIOR B.L.M.

Surveyed AUG 2, 1994 by R.M.SUTTERFIELD