


25758
72425

T. 40 S., R. 14 1/2 E., W.M.

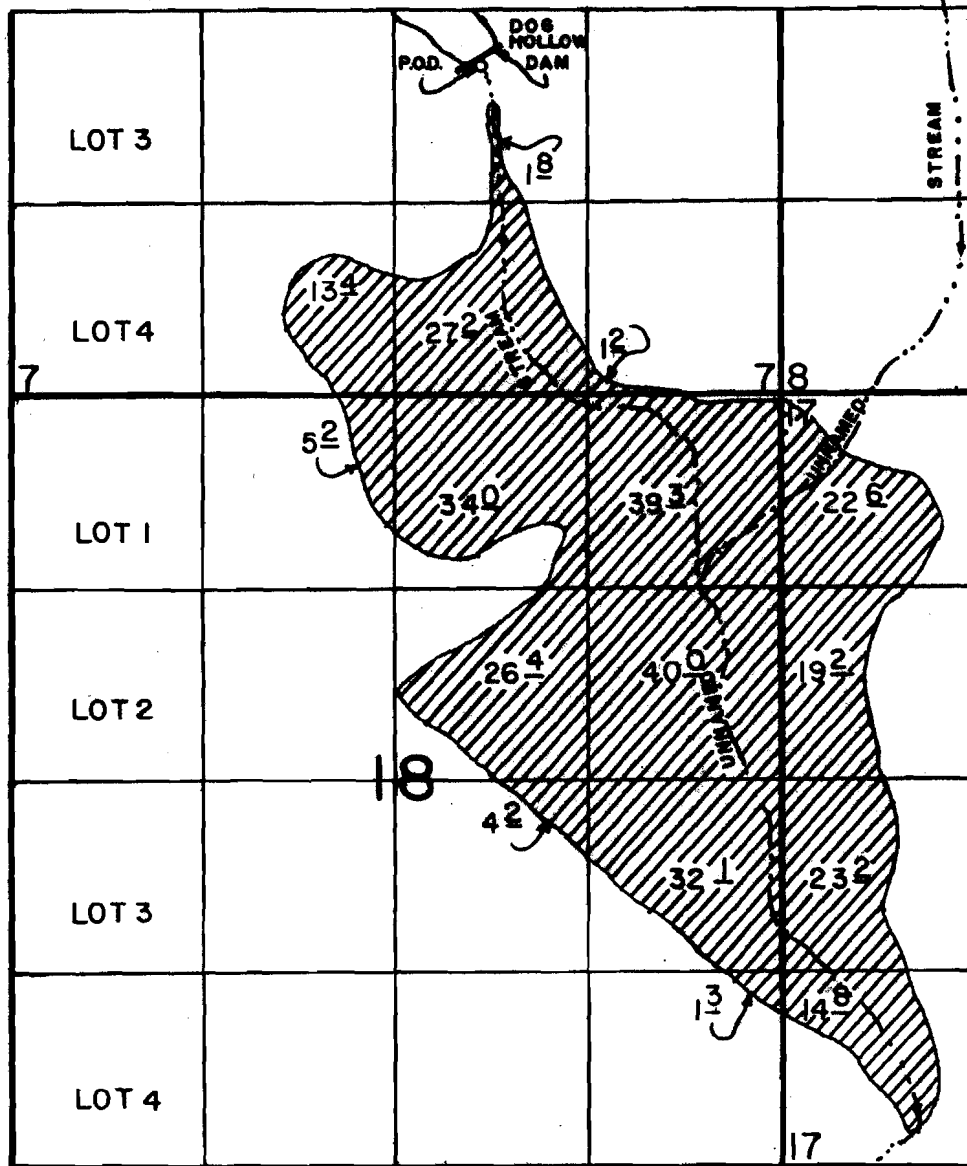

P.O.D. LOC: 2240' N & 2050' W FROM SE COR. OF SEC 7.

SCALE: 1" = 1320'

FINAL PROOF SURVEY UNDER

Application No. 32562 Permit No. 25758
IN NAME OF

305² AC

U.S. DEPARTMENT OF INTERIOR B.L.M.

Surveyed AUG 2, 1994 by R.M. SUTTERFIELD

E. Ba. Lost River Mar.