


T. 3N., R. 10E., W.M.

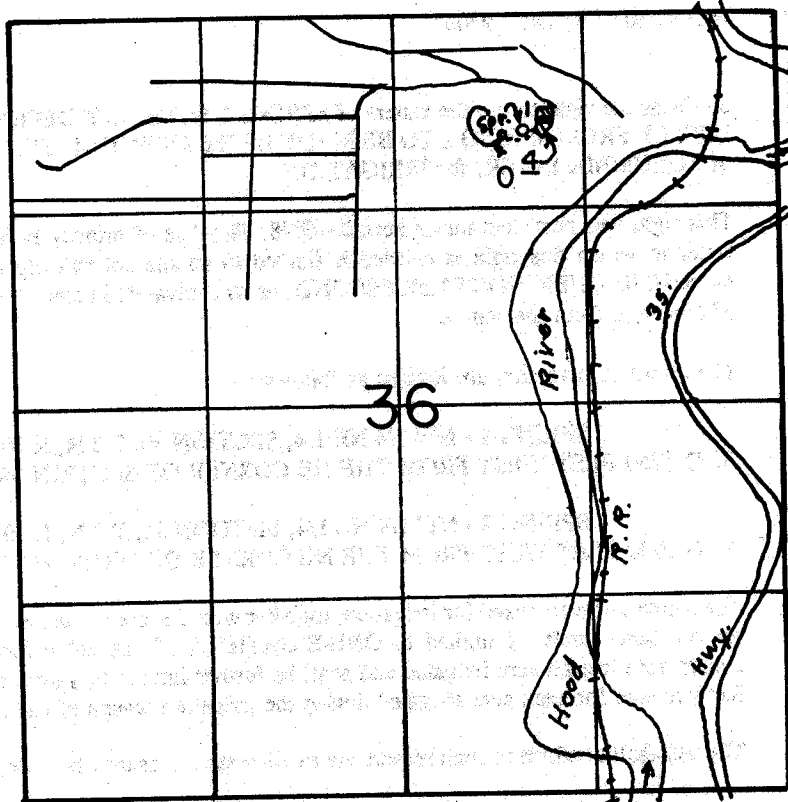

SPR. 1 LOC: 800' S & 1750' W. SPR. 2 LOC: 830' S & 1900' W. BOTH ARE FROM NE COR. OF SEC 36.

SCALE: 1" = 1320'

FINAL PROOF SURVEY
UNDER

Application No. 63645. Permit No. 46898.....
IN NAME OF

.....**DANIEL A. HANNERS**.....

Surveyed **AUG. 16., 1995.** by **R.M. SUTTERFIELD**