


Section 17 Township 23S Range 12W W.M.
Coos County

RECEIVED

NOV 19 1996

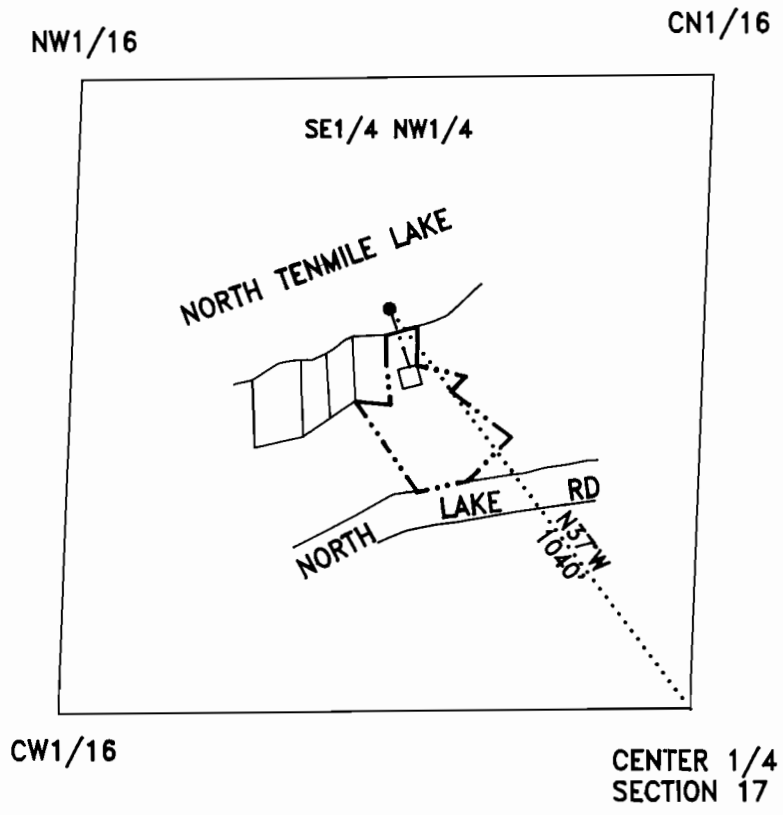


- Legend
- P.O.D.
 - Home
 - - - - - Property Line
 - · · · · Waterline

EXAMINERS DISCLAIMER STATEMENT

The preparation of this map was for the purpose of identifying the location of the Water Right only and has no intent to provide dimensions or location of property ownership lines.

FINAL PROOF SURVEY
IN THE NAME OF
JEAN M. MILLER

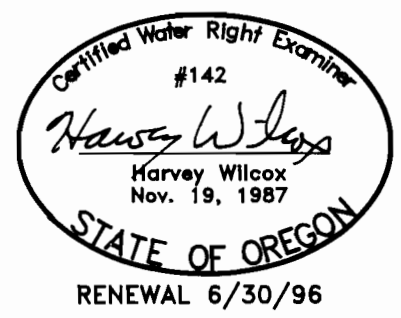

Surveyed on 2/9/96 by H.A. Wilcox

Application No. 73531
Permit No. 51688