


**RECEIVED**

NOV 23 1992

WATER RESOURCES DEPT.  
SALEM, OREGON

**T.4S. R.1E. W.M.**

CLACKAMAS COUNTY

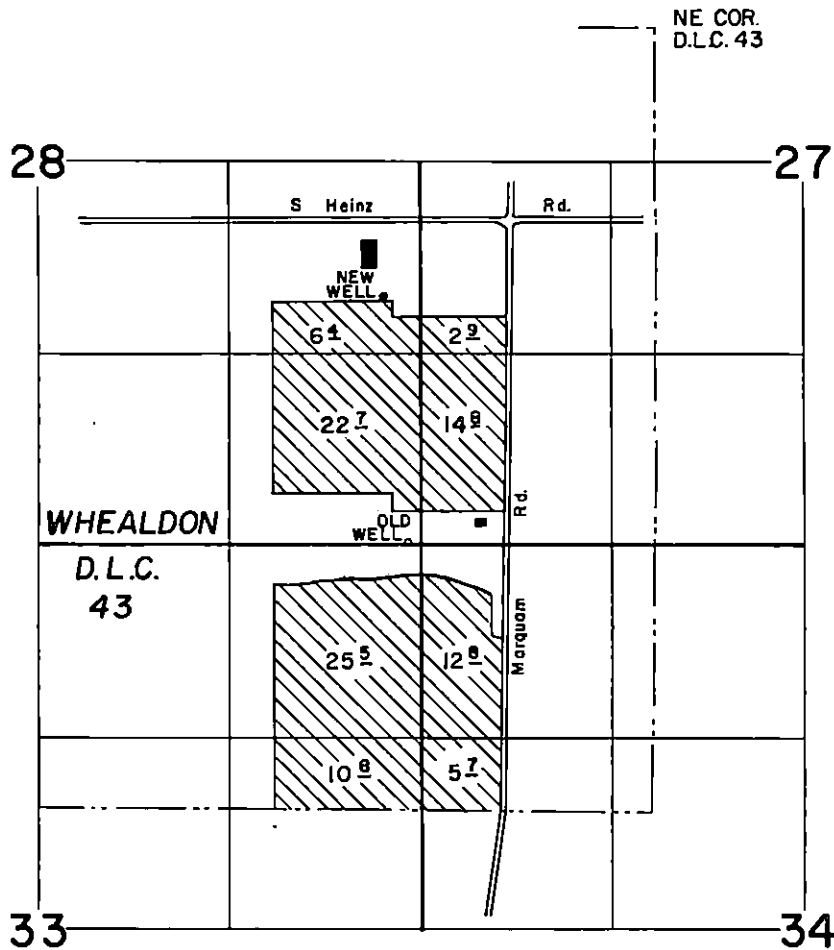


NEW WELL LOCATION 1887' SOUTH & 1924' WEST FROM  
THE NE CORNER OF WHEALDON D.L.C. 43

**FINAL PROOF SURVEY**

Application No G-2980 Permit No G-2776 Transfer No T-6262

**YULE TREE FARMS**

MAY 2, 1990  
SCALE 1"=1320'

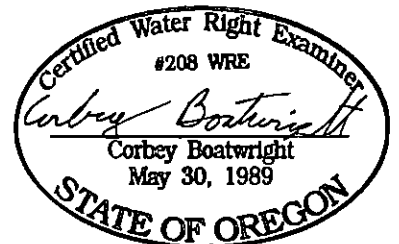

**NOTE:** This map is for the purpose of identifying the location of water rights and has no intent to dimension or locate property ownership lines.