


T.6 S.R.2W.W.M.

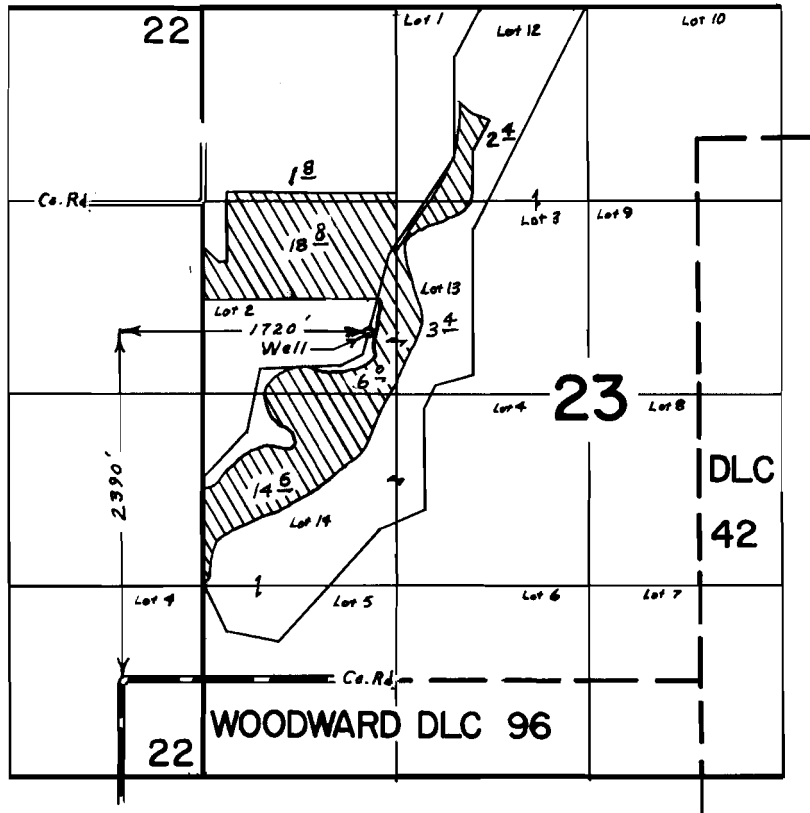

FINAL PROOF SURVEY UNDER

Application No. G-4288 Permit No. G-4057
IN NAME OF

E. M. BOIES

Surveyed JULY 2 1973 by L.E. GOULD