


T.23S.R.10W.W.M.

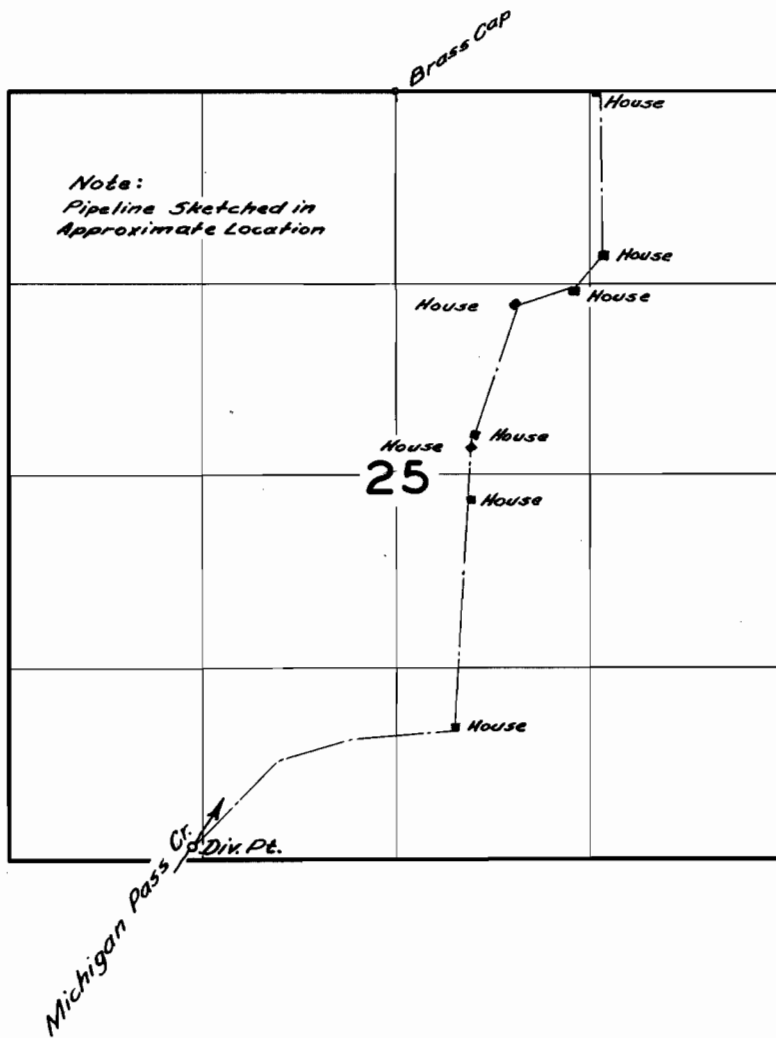

FINAL PROOF SURVEY

UNDER

Application No. 29442 Permit No. 23177
IN NAME OF

Helen M. Judy, et al

Surveyed *June 29 1960*, by *C.D. Bartels*.....