


T. 1S. R. 2W. W.M.

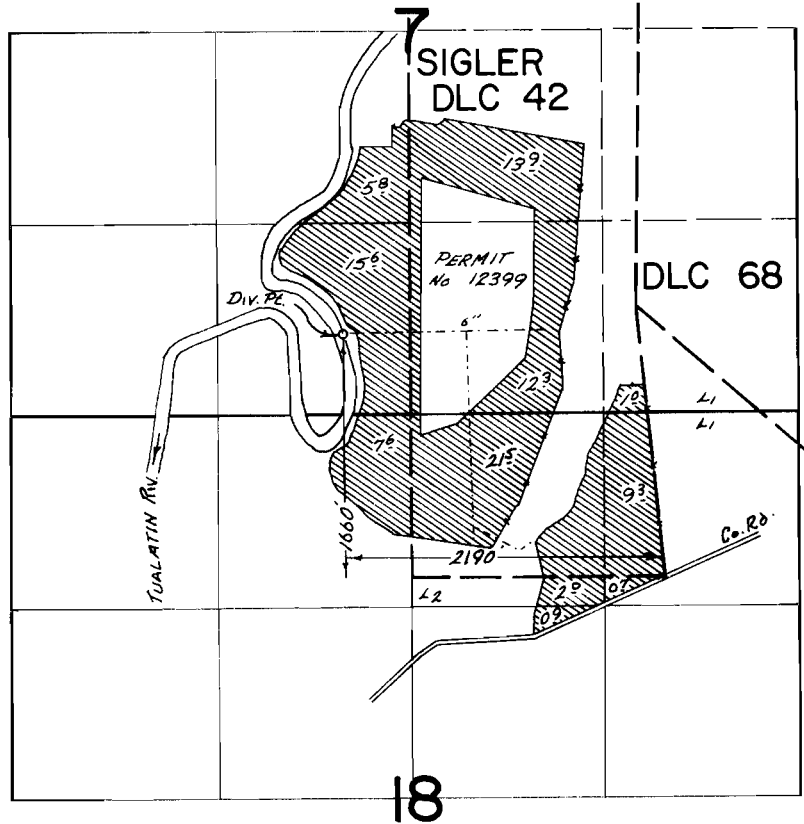

**FINAL PROOF SURVEY**  
UNDER

Transfer No. N-32  
Application No. 42001... Permit No. 31432...  
IN NAME OF

.....**ANTON NUSSBAUMER**.....

Surveyed July 23 1974, by R. G. MUCKEN