


T.9&10S., R.21&22E., W.M.

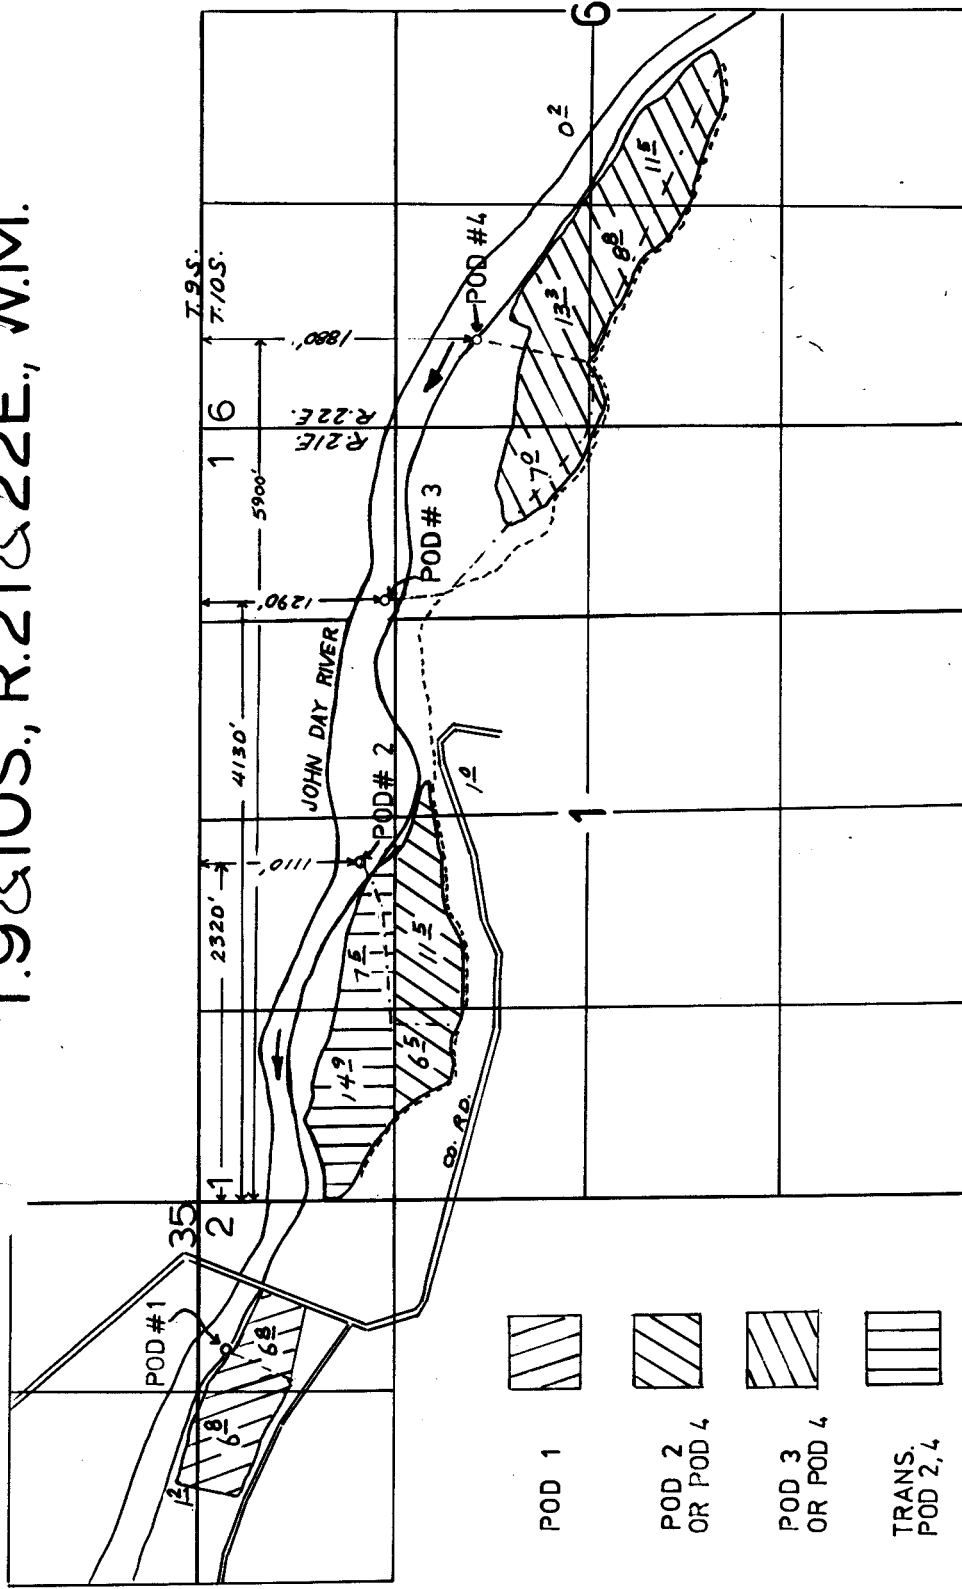

POD 1

POD 2
OR POD 4

POD 3
OR POD 4

TRANS.
POD 2, 4

1" = 1320'

FINAL PROOF SURVEY

UNDER

APPLICATION NO. 64577 PERMIT NO. 47337
TRANSFER NO. 5693

IN NAME OF
JOHN F. AND SHERLA S. COLLINS

SURVEYED 7-2, 1992 BY J. MILLER

POD-1 200' S., & 1020' W.,
FROM THE N.E. COR., SEC. 2.

P 47337

72445

41069-179-156L & 186R