


T.9&10S.R.21&22E.W.M.

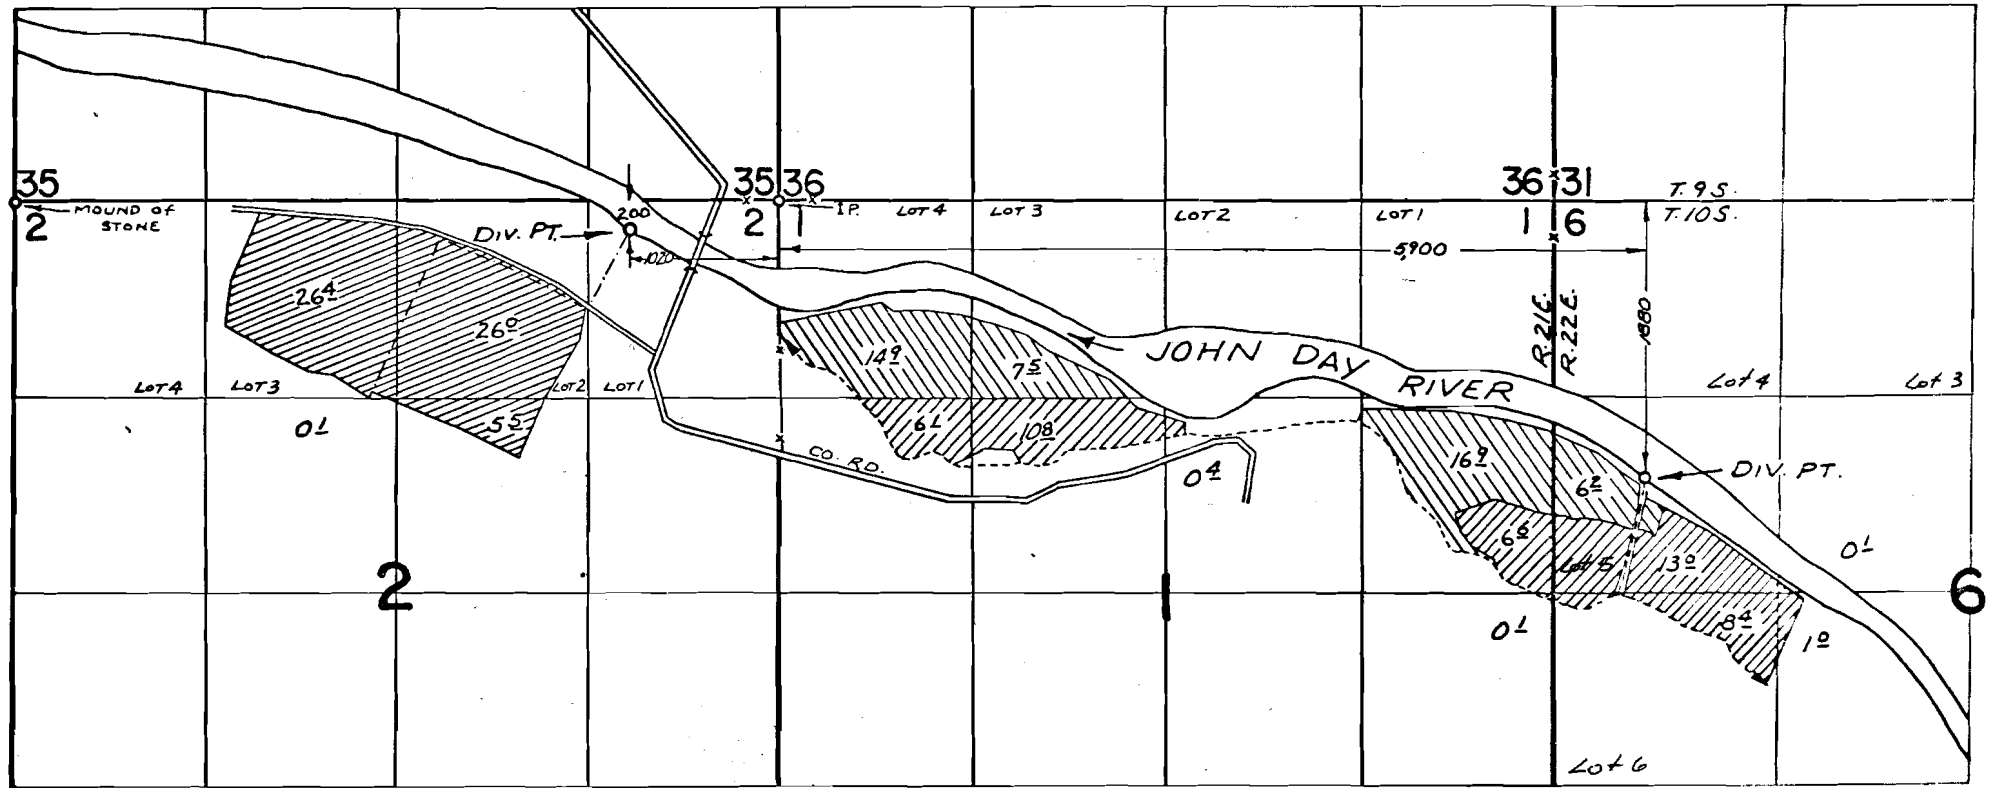

FINAL PROOF SURVEY

UNDER

APPLICATION NO. 44405 ✓ PERMIT NO. 33168
47528 35593

PRIMARY

SUPPLEMENTAL

IN NAME OF
ROBERT W. DAVIS

SURVEYED JULY 18, 1974 BY R. MUCKEN