


FINAL PROOF SURVEY MAP
 IN THE NAME OF HARRY G. SPENCER
 SECTION 11, T30S, R15W, W.M.

APPLICATION:
 R-69883
 69884

PERMIT:
 R-11203
 50948

RECEIVED

STATE OF OREGON
 SALEM, OREGON

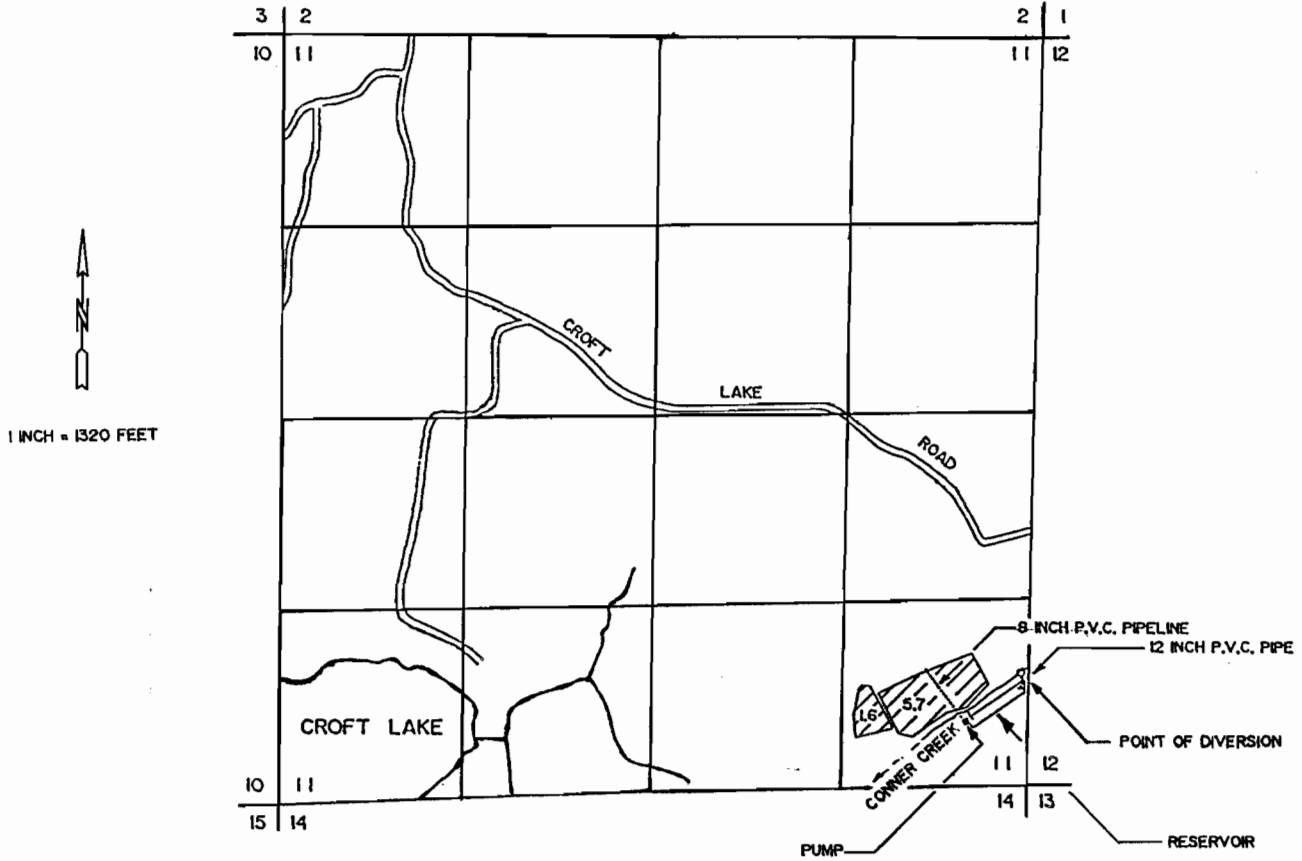

Certified Water Right Examiner
 #054 WRE
James F. Gosson
 James F. Gosson
 Nov. 19, 1987
 STATE OF OREGON

THE POINT OF DIVERSION IS LOCATED 760 FEET NORTH AND 50 FEET WEST FROM THE SOUTHEAST CORNER OF SECTION 11, BEING WITHIN THE SE 1/4 OF THE SE 1/4 OF SECTION 11, TOWNSHIP 30 SOUTH, RANGE 15 WEST, W.M., COOS COUNTY.

THE PURPOSE OF THIS MAP IS TO IDENTIFY THE LOCATION OF THE WATER RIGHT. IT IS NOT INTENDED TO PROVIDE INFORMATION RELATIVE TO THE LOCATION OF PROPERTY OWNERSHIP BOUNDARY LINES.