


TOWNSHIP 25 SOUTH, RANGE 7 WEST, W.M.

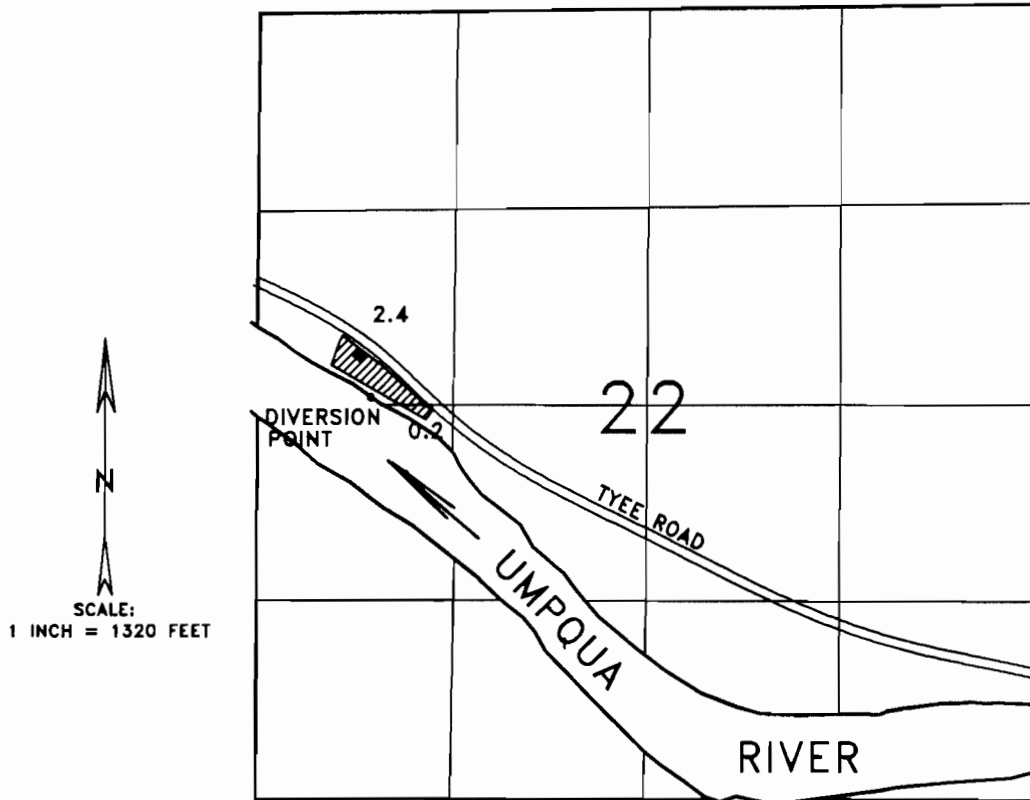

THE DIVERSION POINT IS LOCATED 2640 FEET SOUTH AND 750 FEET EAST FROM THE NORTHWEST CORNER OF SECTION 22.

FINAL PROOF SURVEY
for
RICHARD A. FORNEY
Application 70677
Permit 51160

THE PURPOSE OF THIS MAP IS TO IDENTIFY THE LOCATION OF THE WATER RIGHT. IT IS NOT INTENDED TO PROVIDE INFORMATION RELATIVE TO THE LOCATION OF PROPERTY OWNERSHIP BOUNDARY LINES.

