


Section 10 Township 23S Range 12W W.M.
Coos County

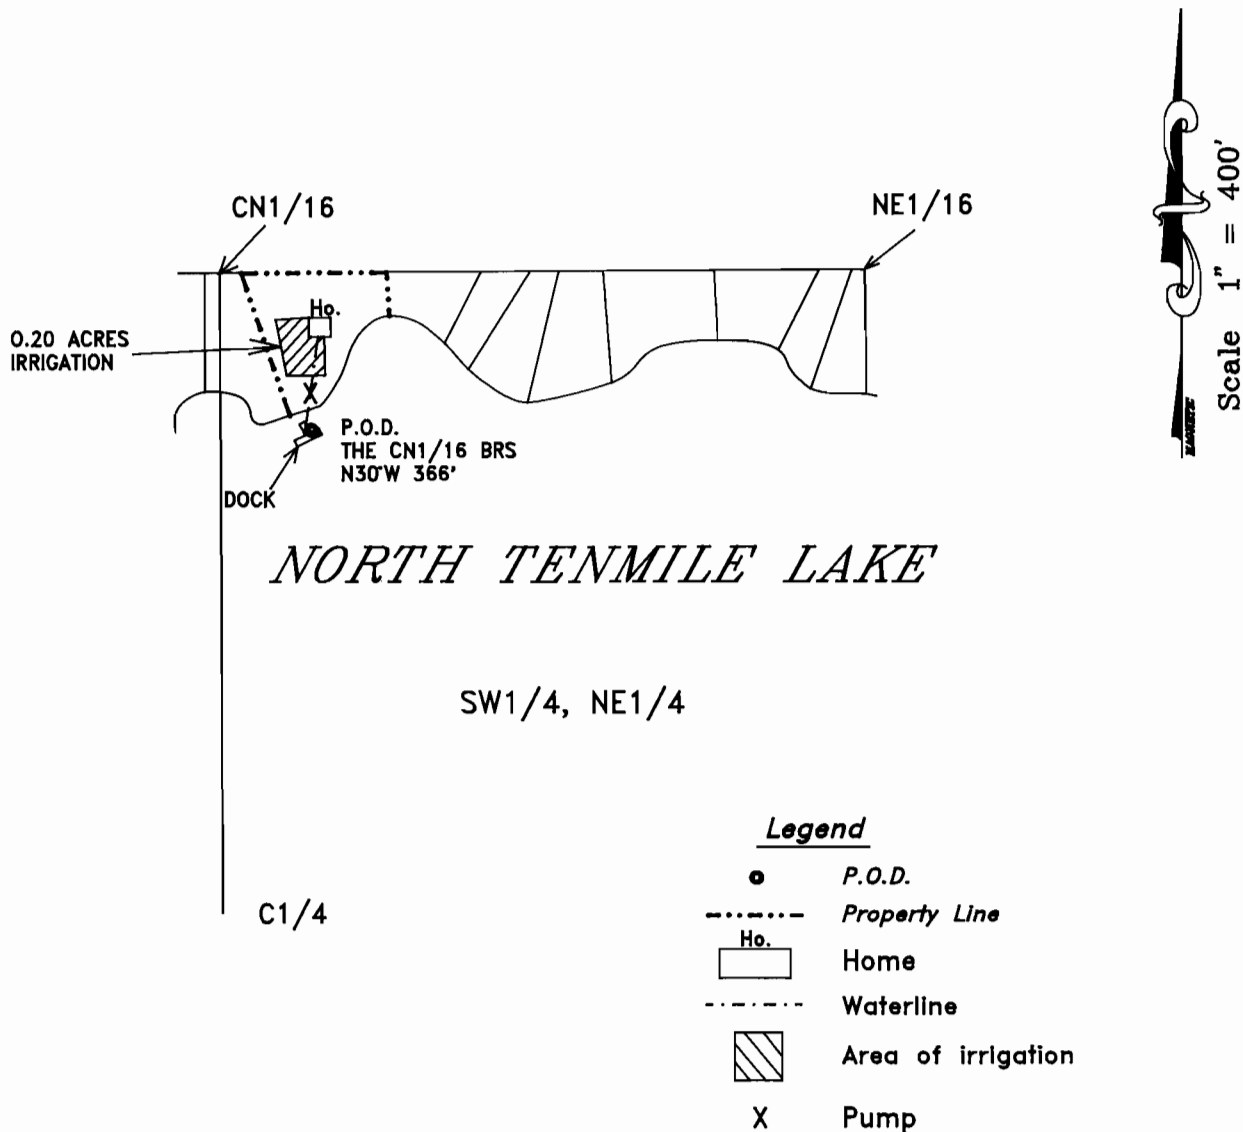


EXAMINERS DISCLAIMER STATEMENT

The preparation of this map was for the purpose of identifying the location of the Water Right only and has no intent to provide dimensions or location of property ownership lines.

FINAL PROOF SURVEY
IN THE NAME OF

Edwin and Marjorie Huuki

Surveyed on August 5, 1995 by H.A. Wilcox

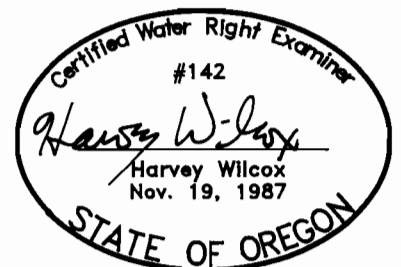

EXPIRES 6/30/96

Application No. 70794
Permit No. 51325