


**Sections 28, 29, 32 & 33
T.13 S. R10 W .W.M.
LINCOLN COUNTY, OREGON**

This map prepared solely for the purpose of showing location of a water right, and is not intended for use to provide dimensions or location of property ownership lines.

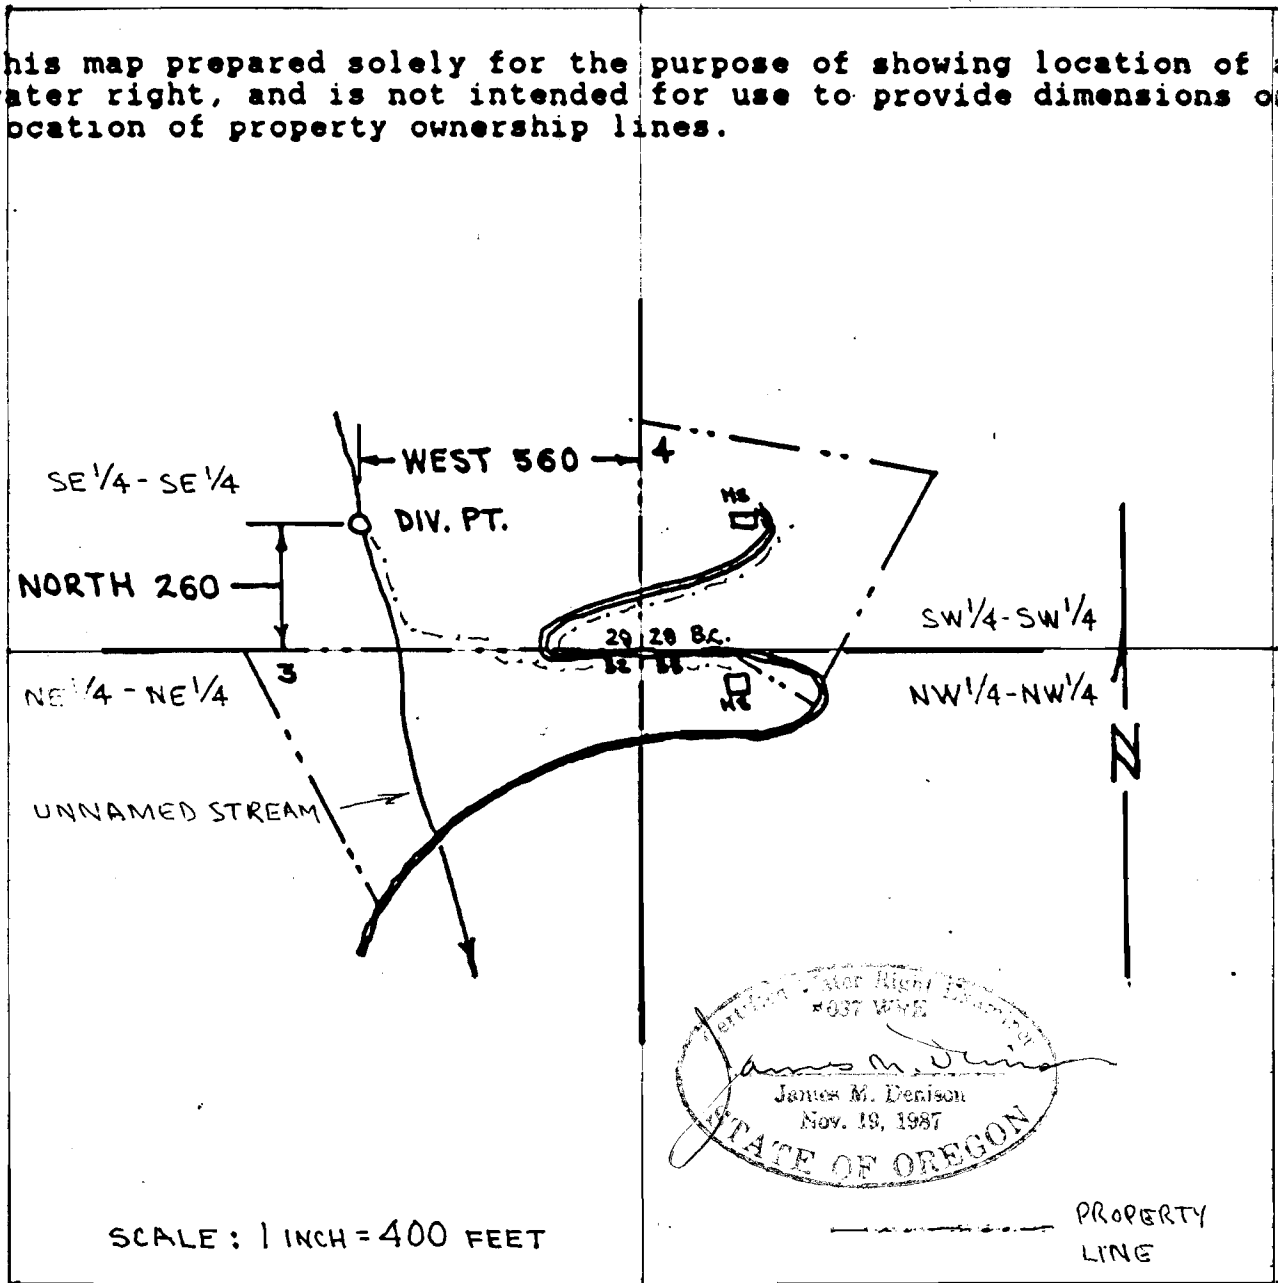

FINAL PROOF SURVEY
UNDER**

APPLICATION #S-71481

PERMIT #51301

**IN THE NAME OF
TERRY W. THISELL & DAVID A. BROOKS**

SURVEYED October 15, 1992

BY J. M. Denison