


T. 15S. R. 4W. W.M.

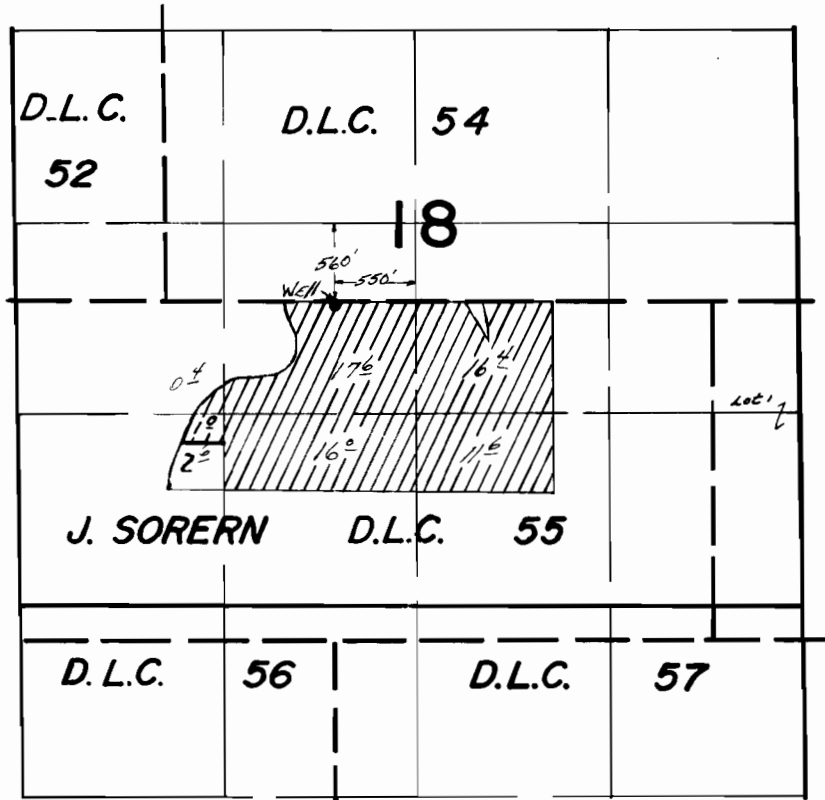

FINAL PROOF SURVEY
UNDER

Application No. G-6995 Permit No. G-6499...
IN NAME OF

JAGER FARMS INC.

Surveyed April 24 1978, by J.S. Donaldson.....