

6. 585

31369

RECEIVED

OCT - 4 1992


WATER RESOURCES DIVISION

72465

T 6248

T 8584

**FINAL PROOF MAP:  
CHANGE IN POINT OF APPROPRIATION  
LLOYD MILES  
LOCATED IN SECTION 2,  
TOWNSHIP 27 SOUTH, RANGE 15 EAST,  
WILLAMETTE MERIDIAN, IN  
LAKE COUNTY, OREGON**

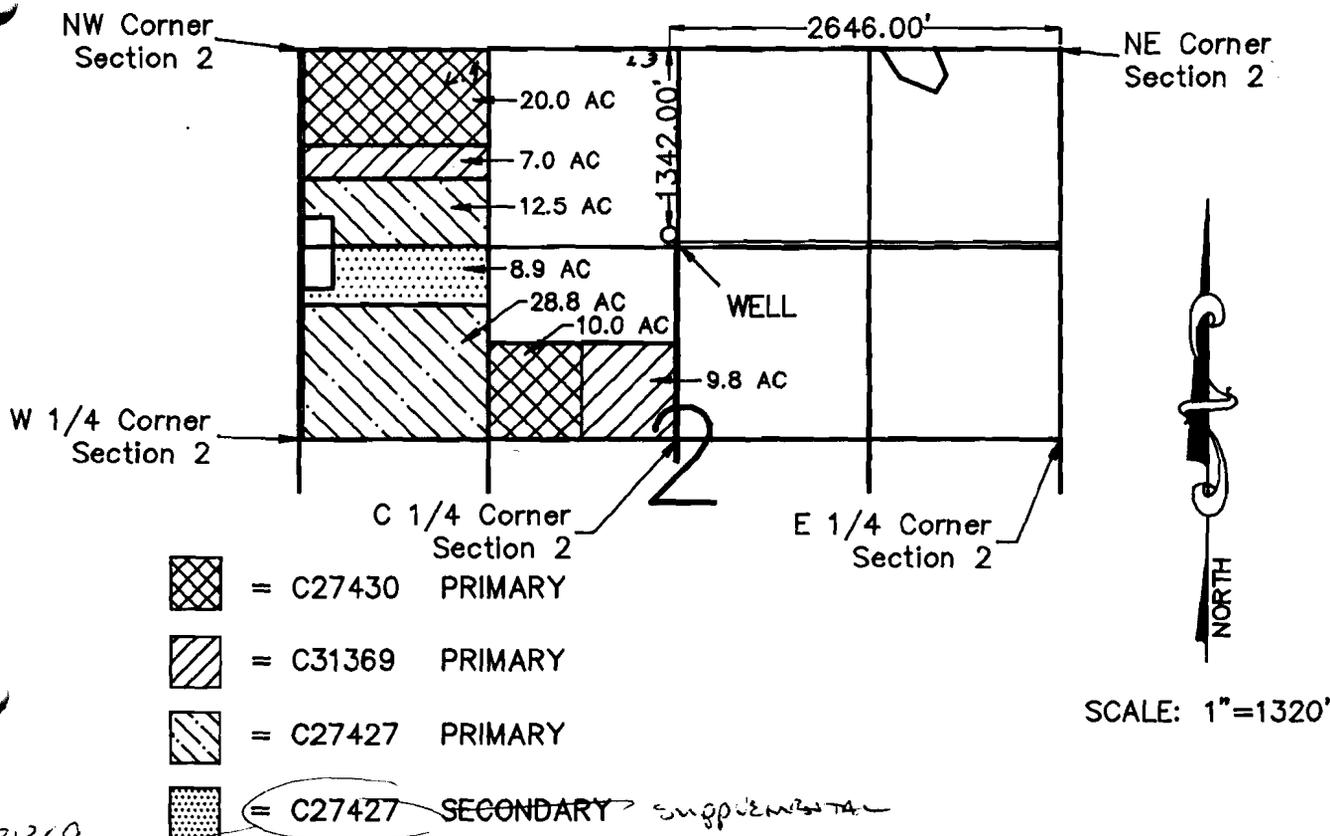


SCALE: 1"=1320'

T-6248 TOTAL IRRIGATED AREA = 97.0 ACRES

I, Michael W. Tye, Certified Water Right Examiner in the State of Oregon, hereby certify that this final proof map was prepared under my direct supervision.

The preparation of this map is for the purpose of identifying the location of the water right only and has no intent to provide dimensions or locations of property ownership lines.

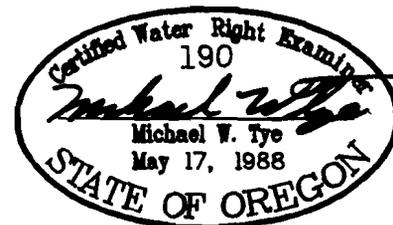

SCALE	1"=1320'	DATE	9-17-92	SURVEY BY	MT&BM	DRAWN BY	P.A.R.	ORDER NO.	3101A
-------	----------	------	---------	-----------	-------	----------	--------	-----------	-------

**SUN COUNTRY ENGINEERING & SURVEYING, INC.**  
 61555 PARRELL ROAD BEND, OREGON 97702 PHONE 382-8882

# T.27S., R.15E., W.M. APPLICATION MAP FOR CHANGE IN POINT OF APPROPRIATION


## RECEIVED

JUN 9 1989

WATER RESOURCES DEPT.  
SALEM, OREGON



SCALE: 1" = 1320'

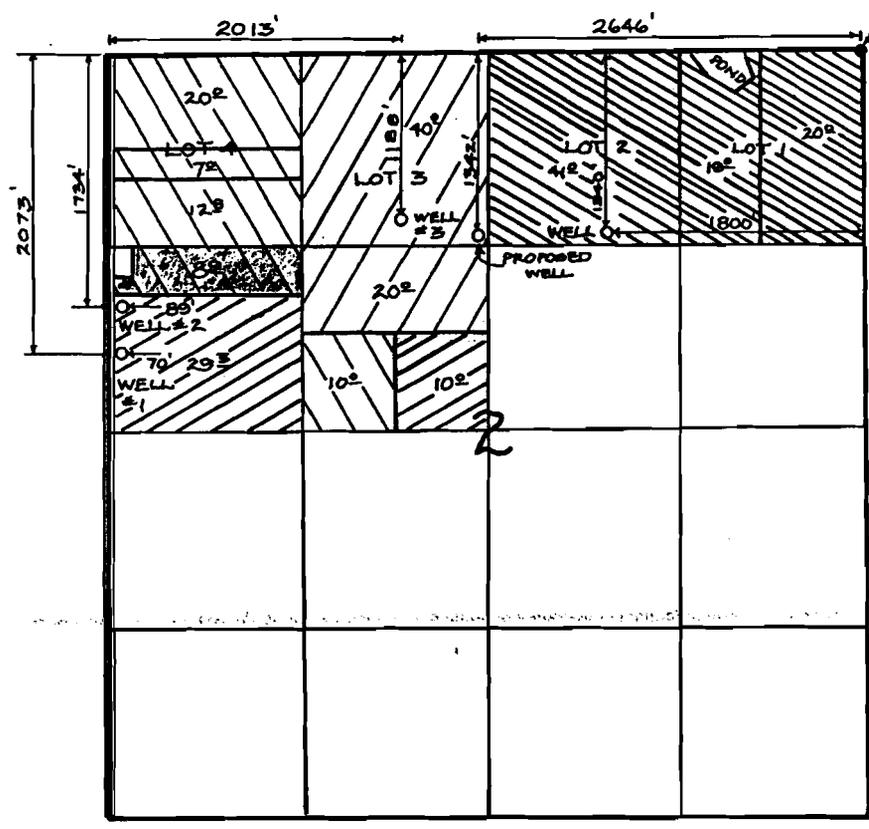

- NOTES:**
- 1.) WELL, WELL #1, #2, #3, TO BE ABANDONED. CHANGE OF APPROPRIATION TO PROPOSED WELL
  - 2.) PRIMARY TOTAL = 2382  
SUPPLEMENTAL = 82

-  WELL; TOTAL = 802; C-41323 & C-47062
-  WELL #1; TOTAL = 39.3; C-31369 & C-27427
-  WELL #2; TOTAL = 58.70; C-27427 & C-27430 & C-31369
-  WELL #3; TOTAL = 602; C-31370 T-6298
-  WELL #1; TOTAL SUPPLEMENTAL 82; C-31369

Certified Water Right Examiner  
 033  
*Gary L. DeJarnatt*  
 Gary L. DeJarnatt  
 Nov. 19, 1987  
 STATE OF OREGON

PREPARED BY:  
 DEJARNATT LAND SURVEYS, INC.  
 63885 N. HWY. 97  
 BEND, OR. 97701

NO REPRESENTATION IS INTENDED TO PROVIDE DIMENSIONS OR LOCATION OF PROPERTY OWNERSHIP LINES.

JOB # 89046  
 SHEET 1 OF 1  
 MAY 17, 1989

T-6248