


T. 4 S. R. 1 E. W.M.

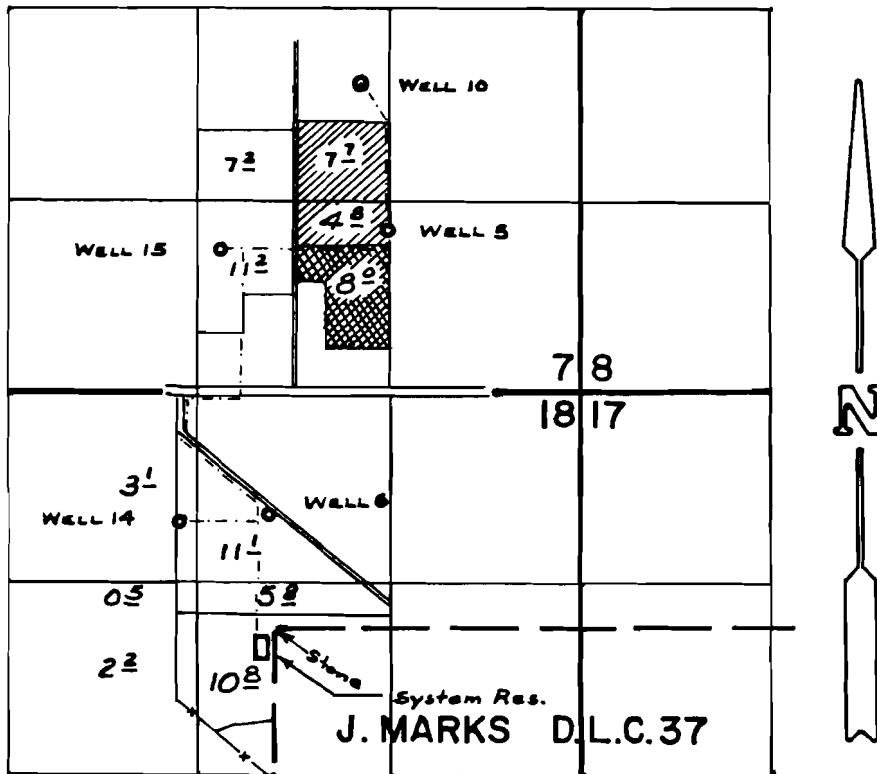

Feb. 21, 1968 Scale 1" = 1320' June 20, 1975

Well 6 loc. 840'S & 470'E.; Well 14 loc. 880'S & 120'W;
 Well 15 loc. 970'N & 160'E; All from 1/4 Cor. bet. Sec. 7 & 18.
 Well 5 loc. 1130'N & 1330'W. from SE cor. Sec. 7
 Well 10 loc. 2120'N & 180'W. from SE cor. SW 1/4 SE 1/4 Sec. 7

CLAIM OF BENEFICIAL USE
FOR
WEYERHAEUSER CO.
 Transfer No. 6340

THE PREPARATION OF THIS MAP IS FOR THE PURPOSE OF IDENTIFYING THE LOCATION OF THE WATER RIGHT ONLY AND HAS NO INTENT TO PROVIDE DIMENSIONS OR LOCATION OF PROPERTY OWNERSHIP LINES.

