
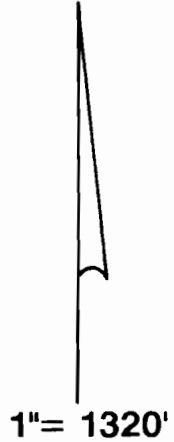


T.6S., R.4W., W.M.

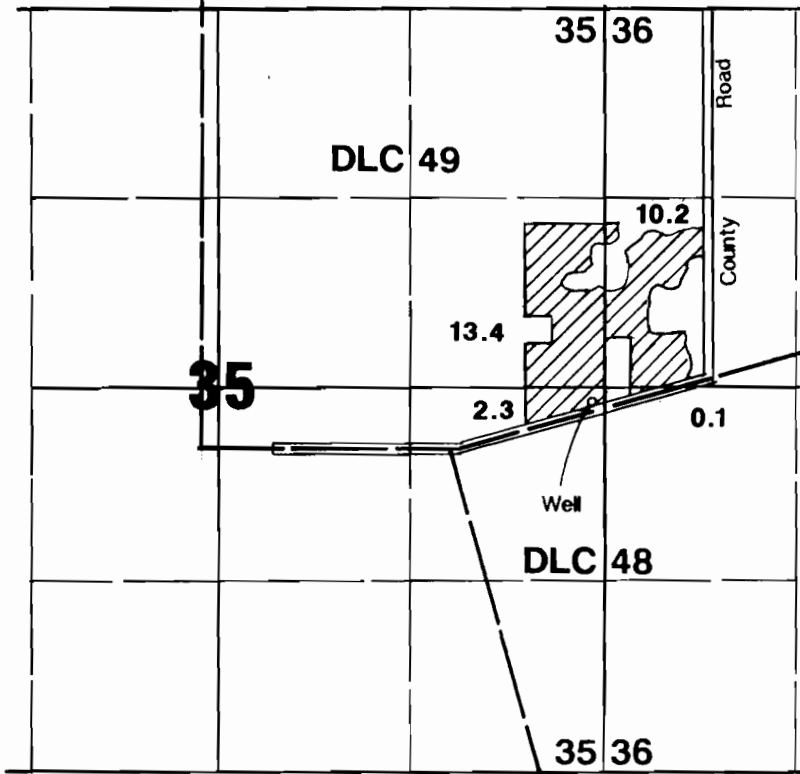

Well located 2550'N & 80'W from SE corner Section 35.

Final Proof Survey

Application #: G-12214

Permit #: G-11384

In Name Of

Harold S. Boyd

Surveyed on November 8, 1994 by JM Schuette

THIS MAP WAS PREPARED FOR THE PURPOSE OF IDENTIFYING THE LOCATION OF A WATER RIGHT ONLY AND IS NOT INTENDED TO PROVIDE LEGAL DIMENSIONS OR LOCATION OF PROPERTY OWNERSHIP LINES.

