
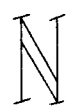



TOWNSHIP 15 SOUTH, RANGE 4 WEST, W.M.

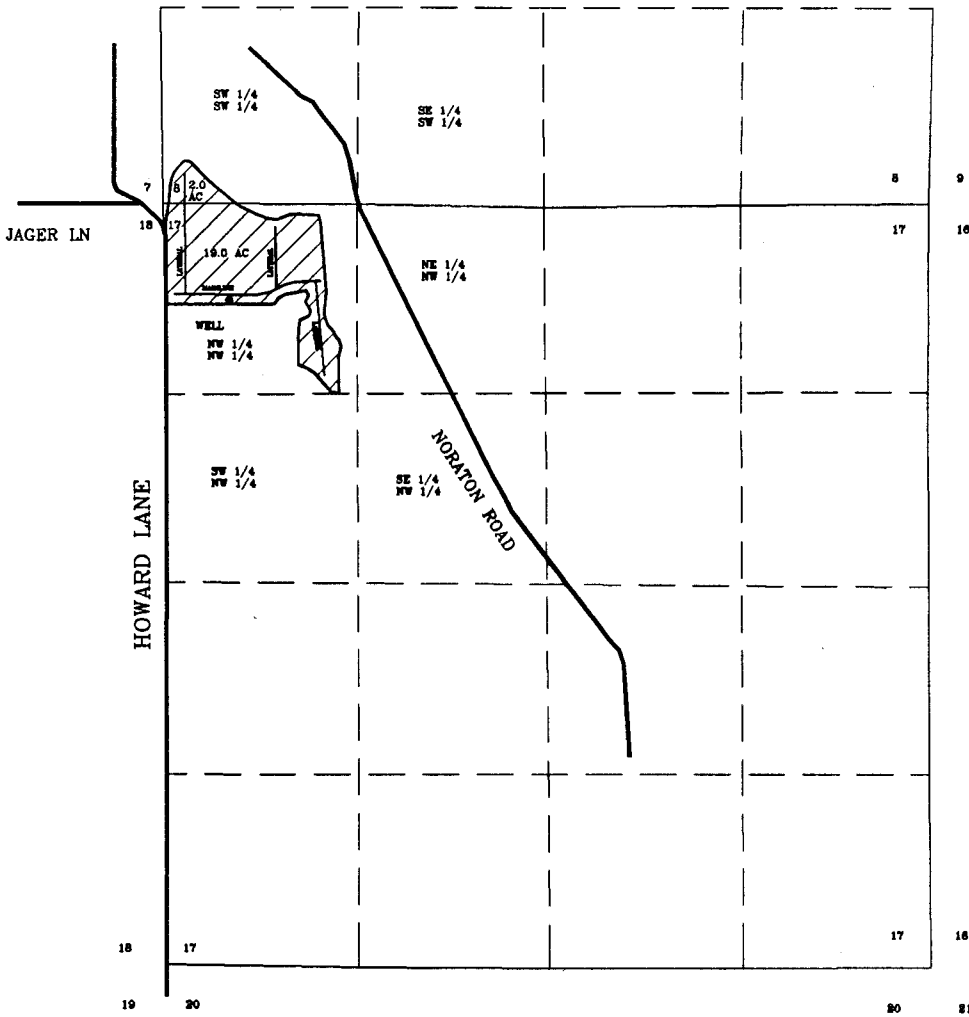

SCALE 1" = 1320'

WELL LOCATION:  
660.08' SOUTH &  
452.47' EAST OF  
NORTHWEST CORNER  
SECTION 17.

FINAL PROOF SURVEY  
PER .  
APPLICATION G-12308 & PERMIT G-11215  
FOR  
GORDON R. JAGER AND JAGER FARMS, INC.  
28645 JAGER LANE  
JUNCTION CITY, OREGON 97448  
PH (503)998-2572  
BY  
STEPHEN H. FORD INC.  
1120 BAILEY HILL RD. #5  
EUGENE, OREGON 97402  
(503)344-1852

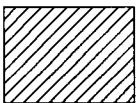

FINAL PROOF AREA

NOTE:  
THIS MAP WAS PREPARED FOR THE  
PURPOSE OF IDENTIFYING THE LOCATION  
OF THE WATER RIGHT ONLY. IT IS  
NOT INTENDED TO PROVIDE DIMENSIONS  
OR LOCATION OF PROPERTY OWNERSHIP  
LINES.

