


43128
72478

T. 39 S., R. 13 E., W.M.
T. 40S., R. 14 E., W. M.

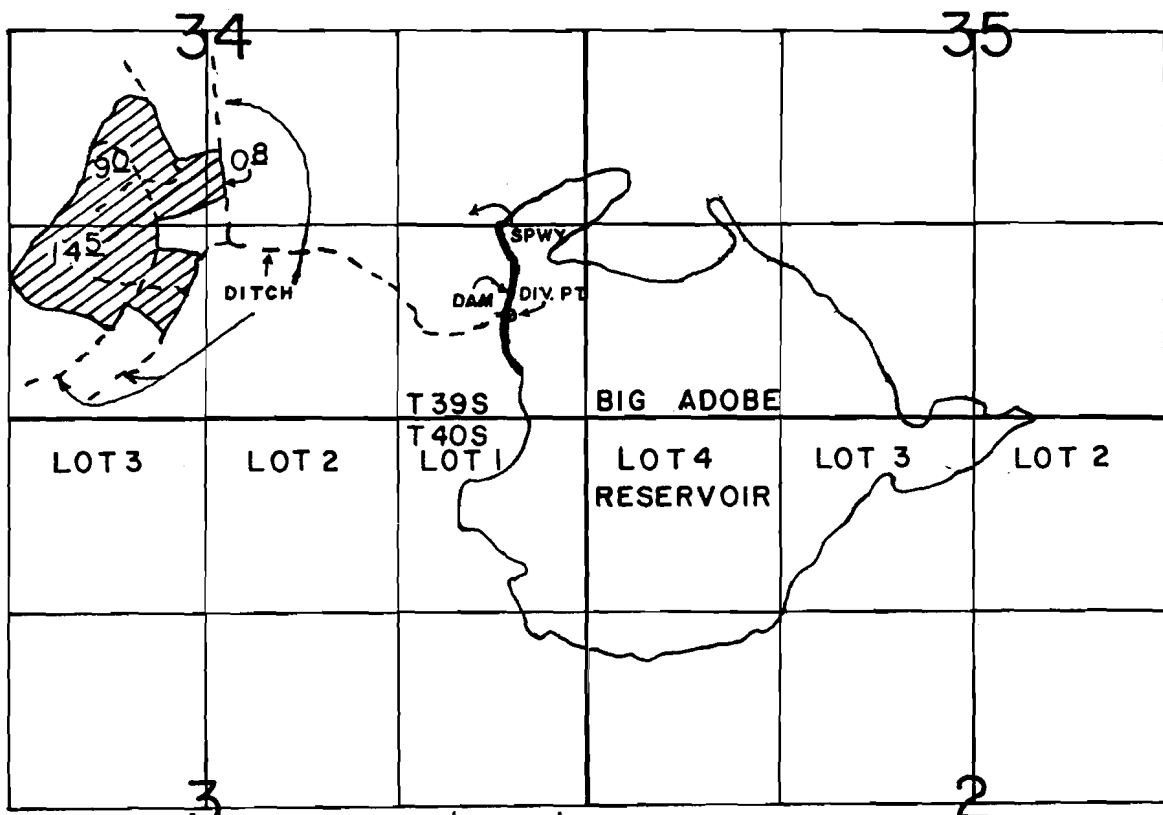

DIV. PT. LOC: 680' N & 510' W FROM SE COR. OF SEC 34.

SCALE: 1" = 1320'

FINAL PROOF SURVEY

UNDER

R45534 R 7397
Application No. 45535 Permit No. 43128
IN NAME OF

U.S.D.I., BUREAU OF LAND MANAGEMENT

Surveyed JUNE 2., 1992, by B.W. BISHOP

Miller Creek & Mts.