


T30S, R3W, WM

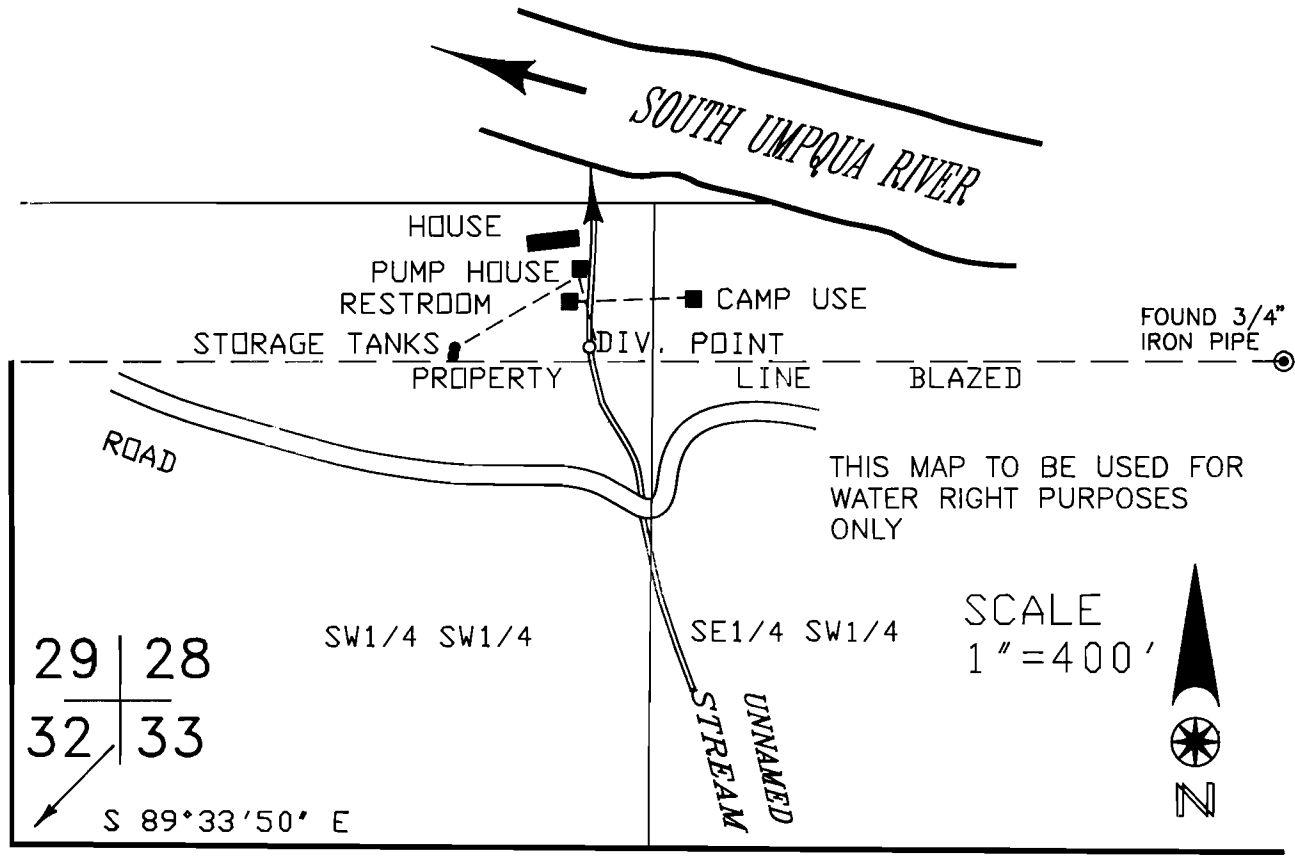

29	28
32	33

SW1/4 SW1/4

SE1/4 SW1/4

SCALE
1" = 400'



S 89°33'50" E

DIVERSION POINT 1035 FEET NORTH AND 1210 FEET EAST FROM THE SW CORNER OF SECTION 28

FINAL PROOF SURVEY
 FOR APPLICATION 69582, PERMIT 50855 IN NAME OF
GREEN MOUNTAIN LUTHERAN CAMP, INC.

MAP PREPARED BY
 WILLIAM J. RUPPERT
 P.O. BOX 1564
 MYRTLE CREEK, OR 97457

MAY 1993

