


T. 27 S., R. 12 W., SEC. 24

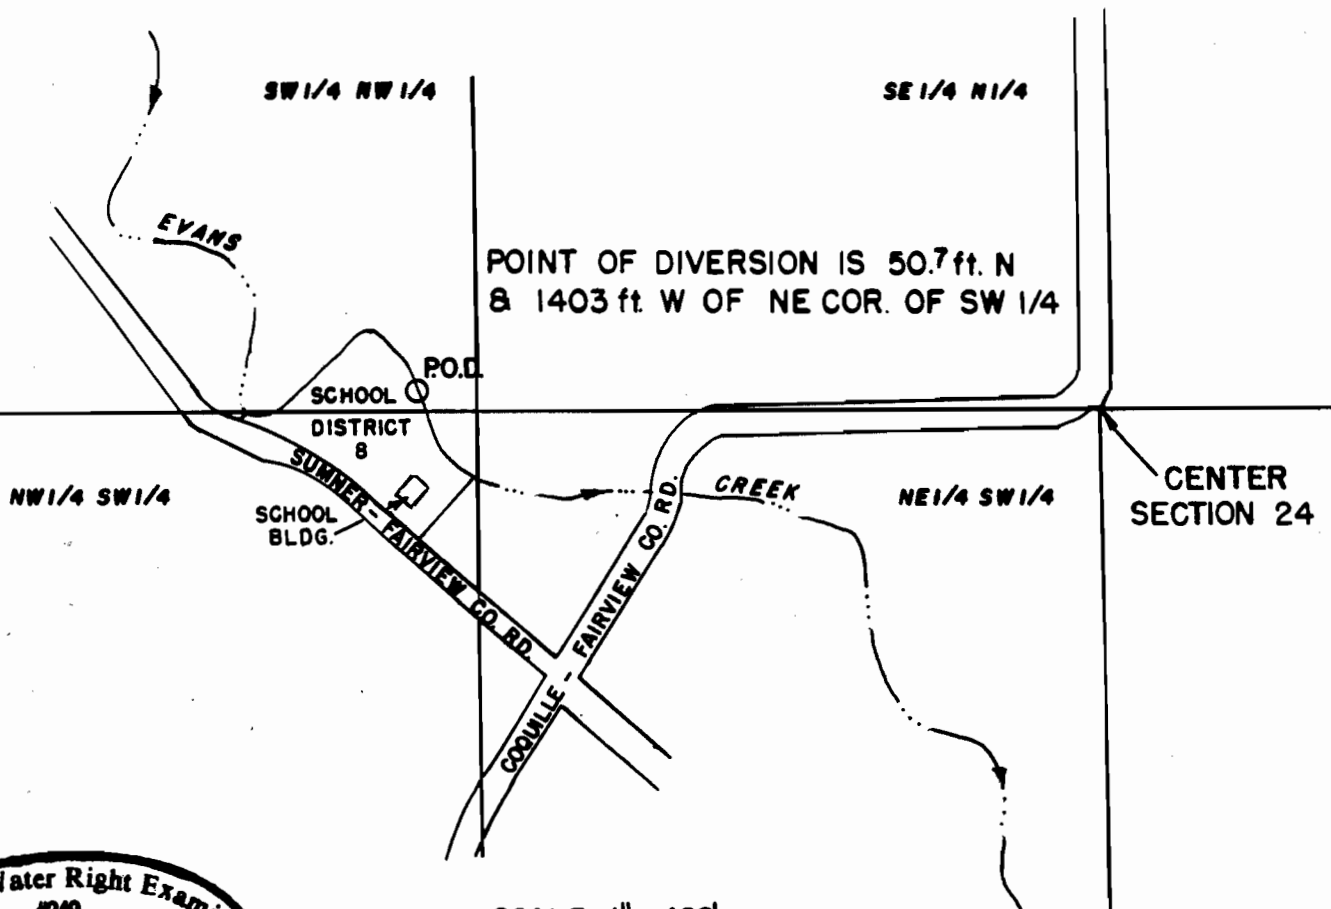

SCALE: 1" = 400'



FINAL PROOF SURVEY

UNDER

Application No. 70244... Permit No. 51035...

IN NAME OF

COQUILLE SCHOOL DISTRICT # 8