

UNITED STATES
DEPARTMENT OF THE INTERIOR
BUREAU OF LAND MANAGEMENT

SECTION


Oregon State Water Filings

29

TOWNSHIP 40³, RANGE 39E, W. M.

Turner Res.

North

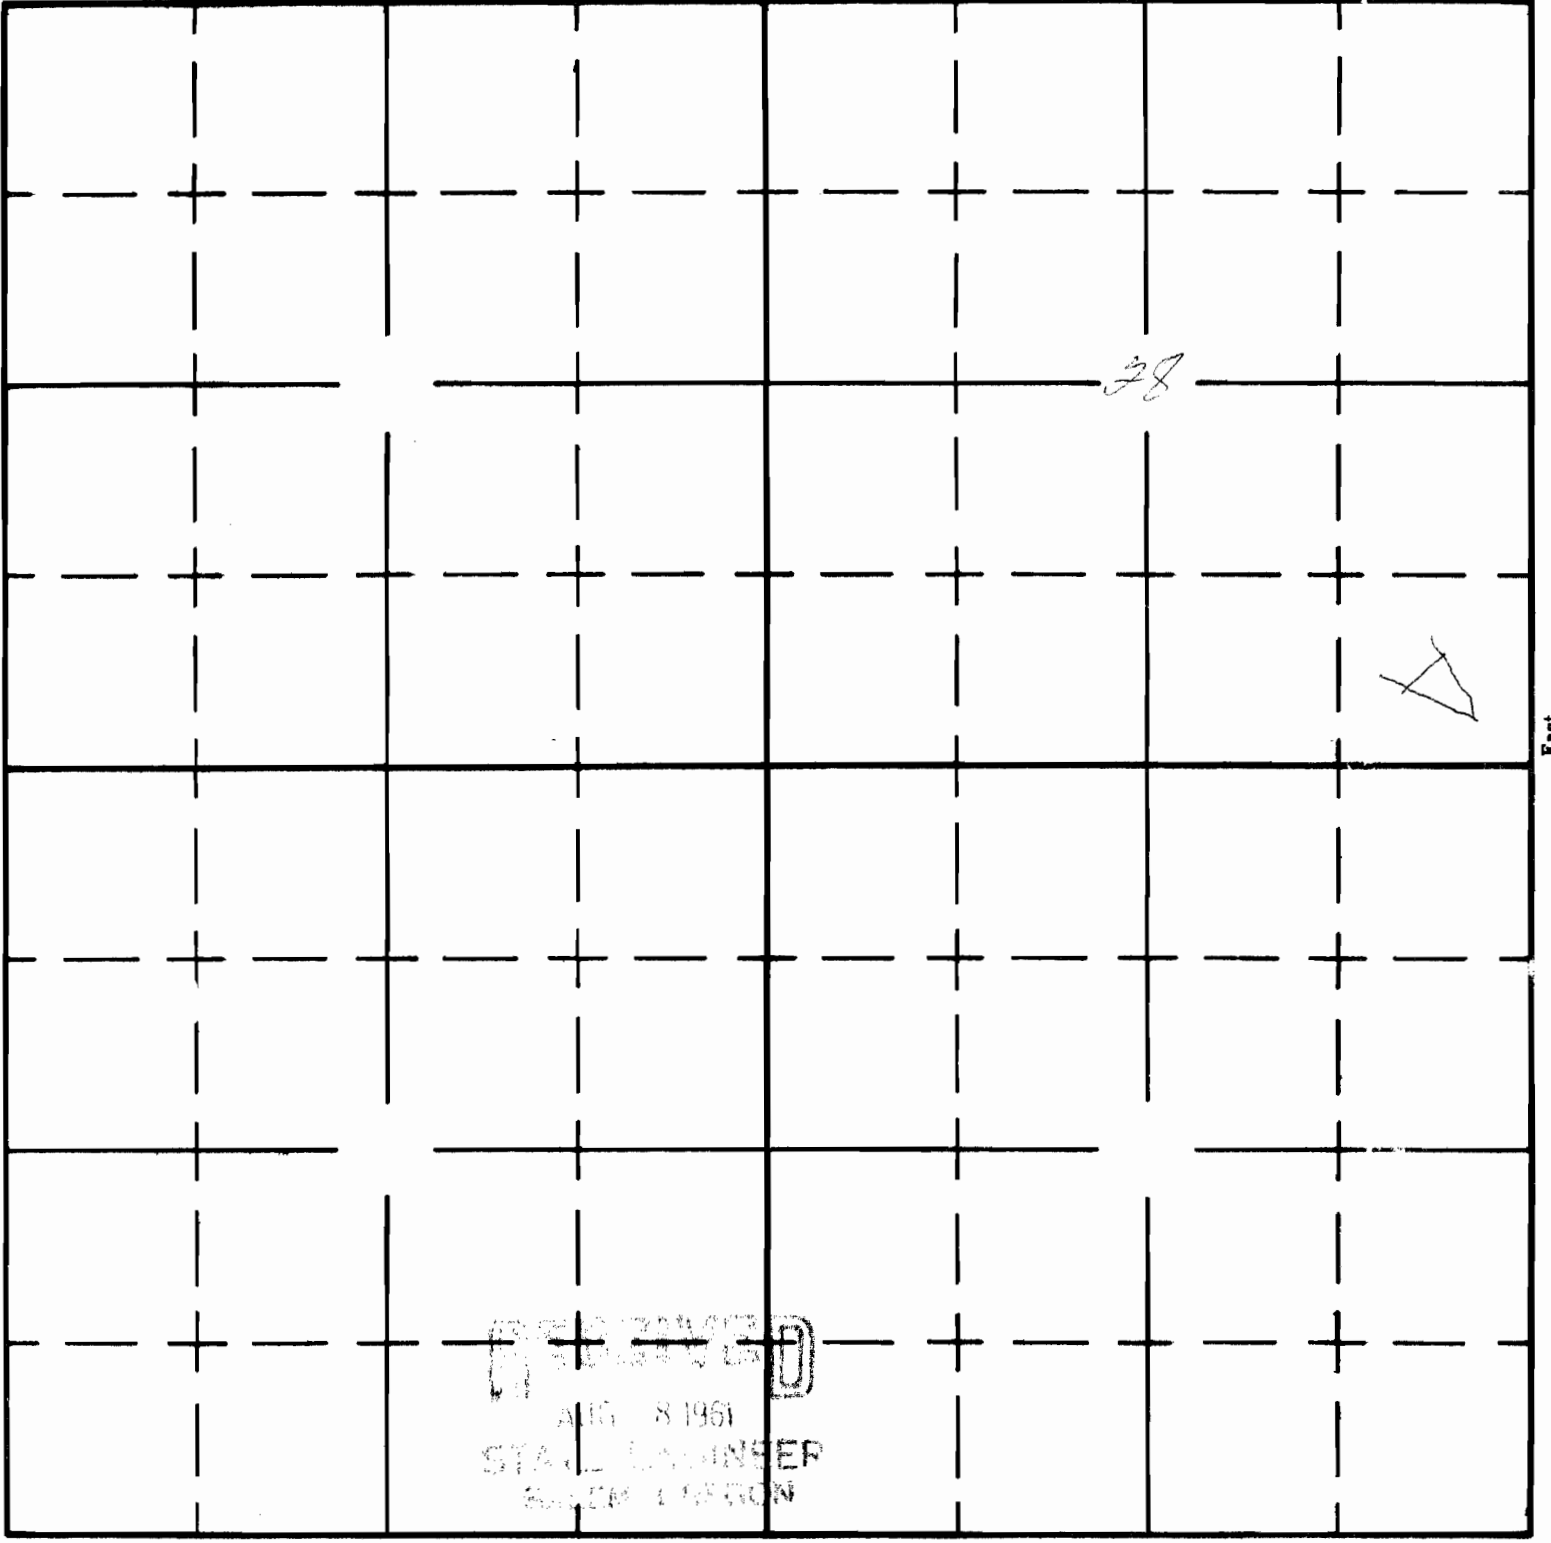

West

East

South

APPLICATION No. *R-36712*
PERMIT No. *R-4326*