


T. 8 S. R. 39 E. W.M.

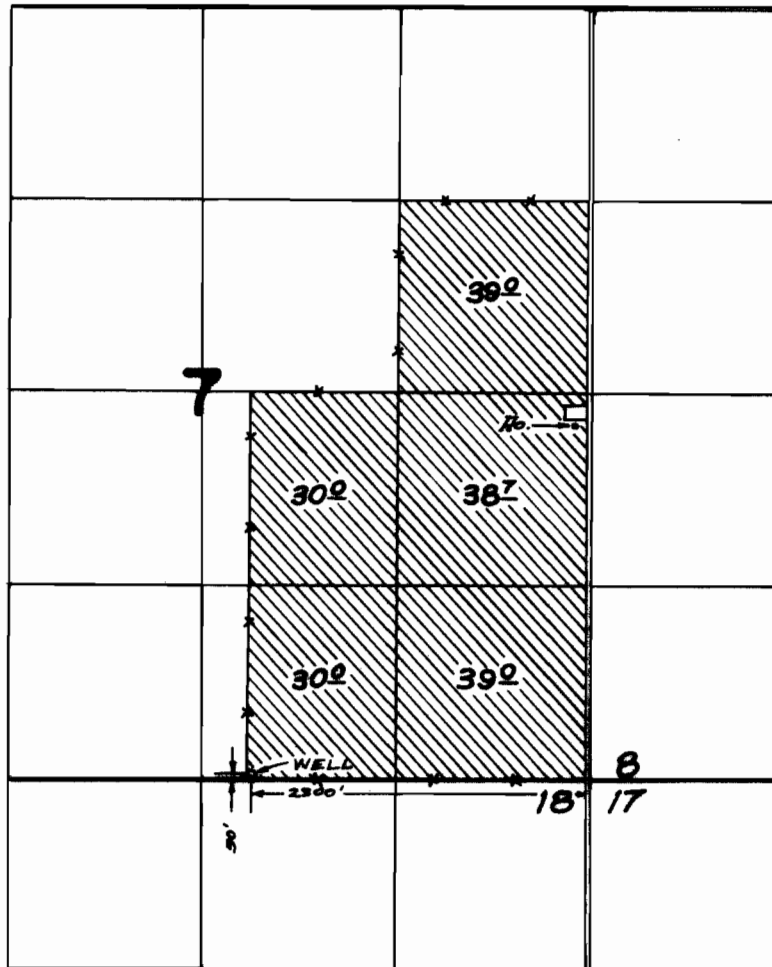

FINAL PROOF SURVEY UNDER

Application No. G 5551 Permit No. G 4970
IN NAME OF

THOMAS L. & JEAN B. GRIFFITH

Surveyed OCT. 30 19.74, by L.M. TOLL