T. 8S. R. 39E. W.M.

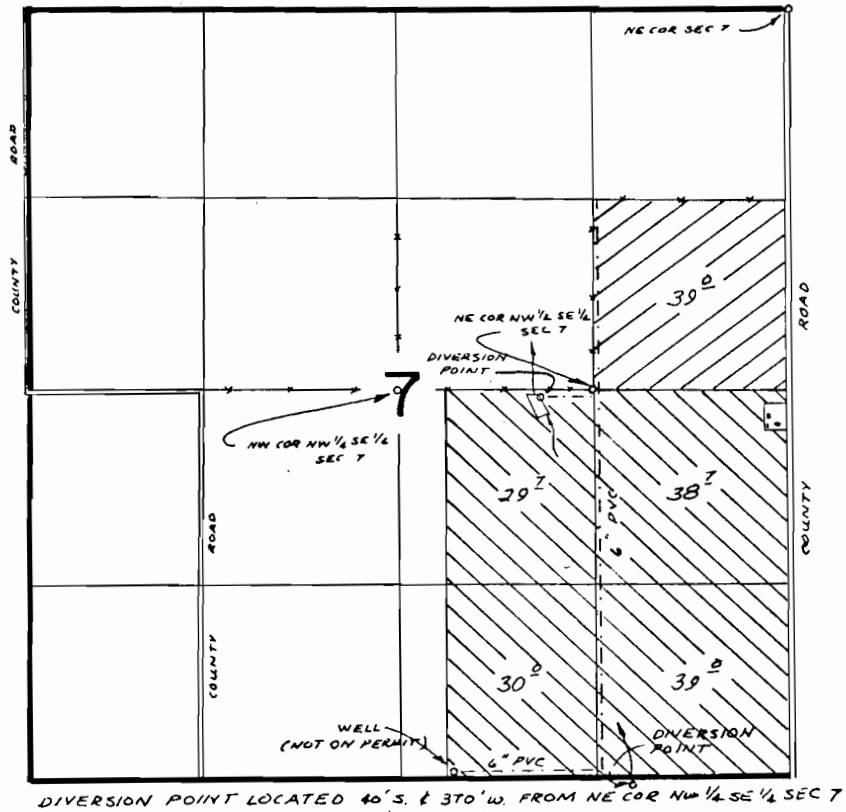

DIVERSION POINT LOCATED 40'S. & 370'W. FROM NE COR NW 1/4 SE 1/4 SEC 7
DIVERSION POINT LOCATED 50'S. & 1110'W. FROM SE COR SEC 7

SUPPL TO CERT 4687

SUPPL TO CERTS 4081, 7475, 41951

FINAL PROOF SURVEY

UNDER

53003	40307
R53164	R6424

Application No. 50401 Permit No. 39119

IN NAME OF

THOMAS L. & JEAN B. GRIFFITH

Surveyed OCT 26 1977, by R. BARWIN

BBB-4KK-240
PTS-1977-5-B