


T. 8 S. R. 39 E. W. M.

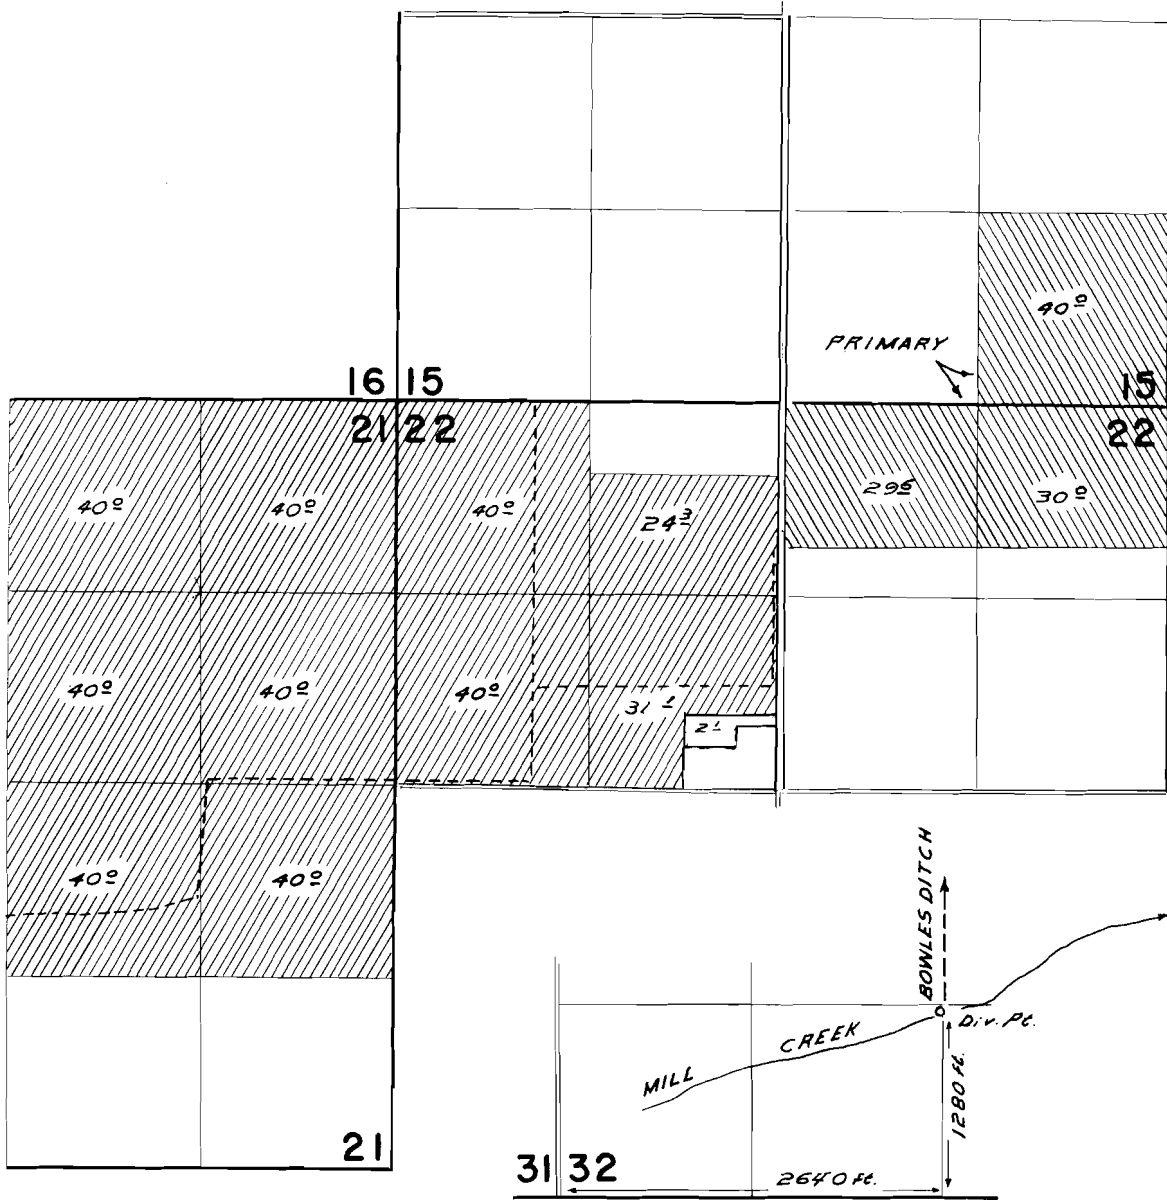

FINAL PROOF SURVEY
UNDER

Application No. **33510** Permit No. **26504**
IN NAME OF

NORBERT L. SIEG

Surveyed **NOV. 16, 17 1964**, by **C. GARDNER**