






Tp. 1, N.

Rg. 42, E.W.M.

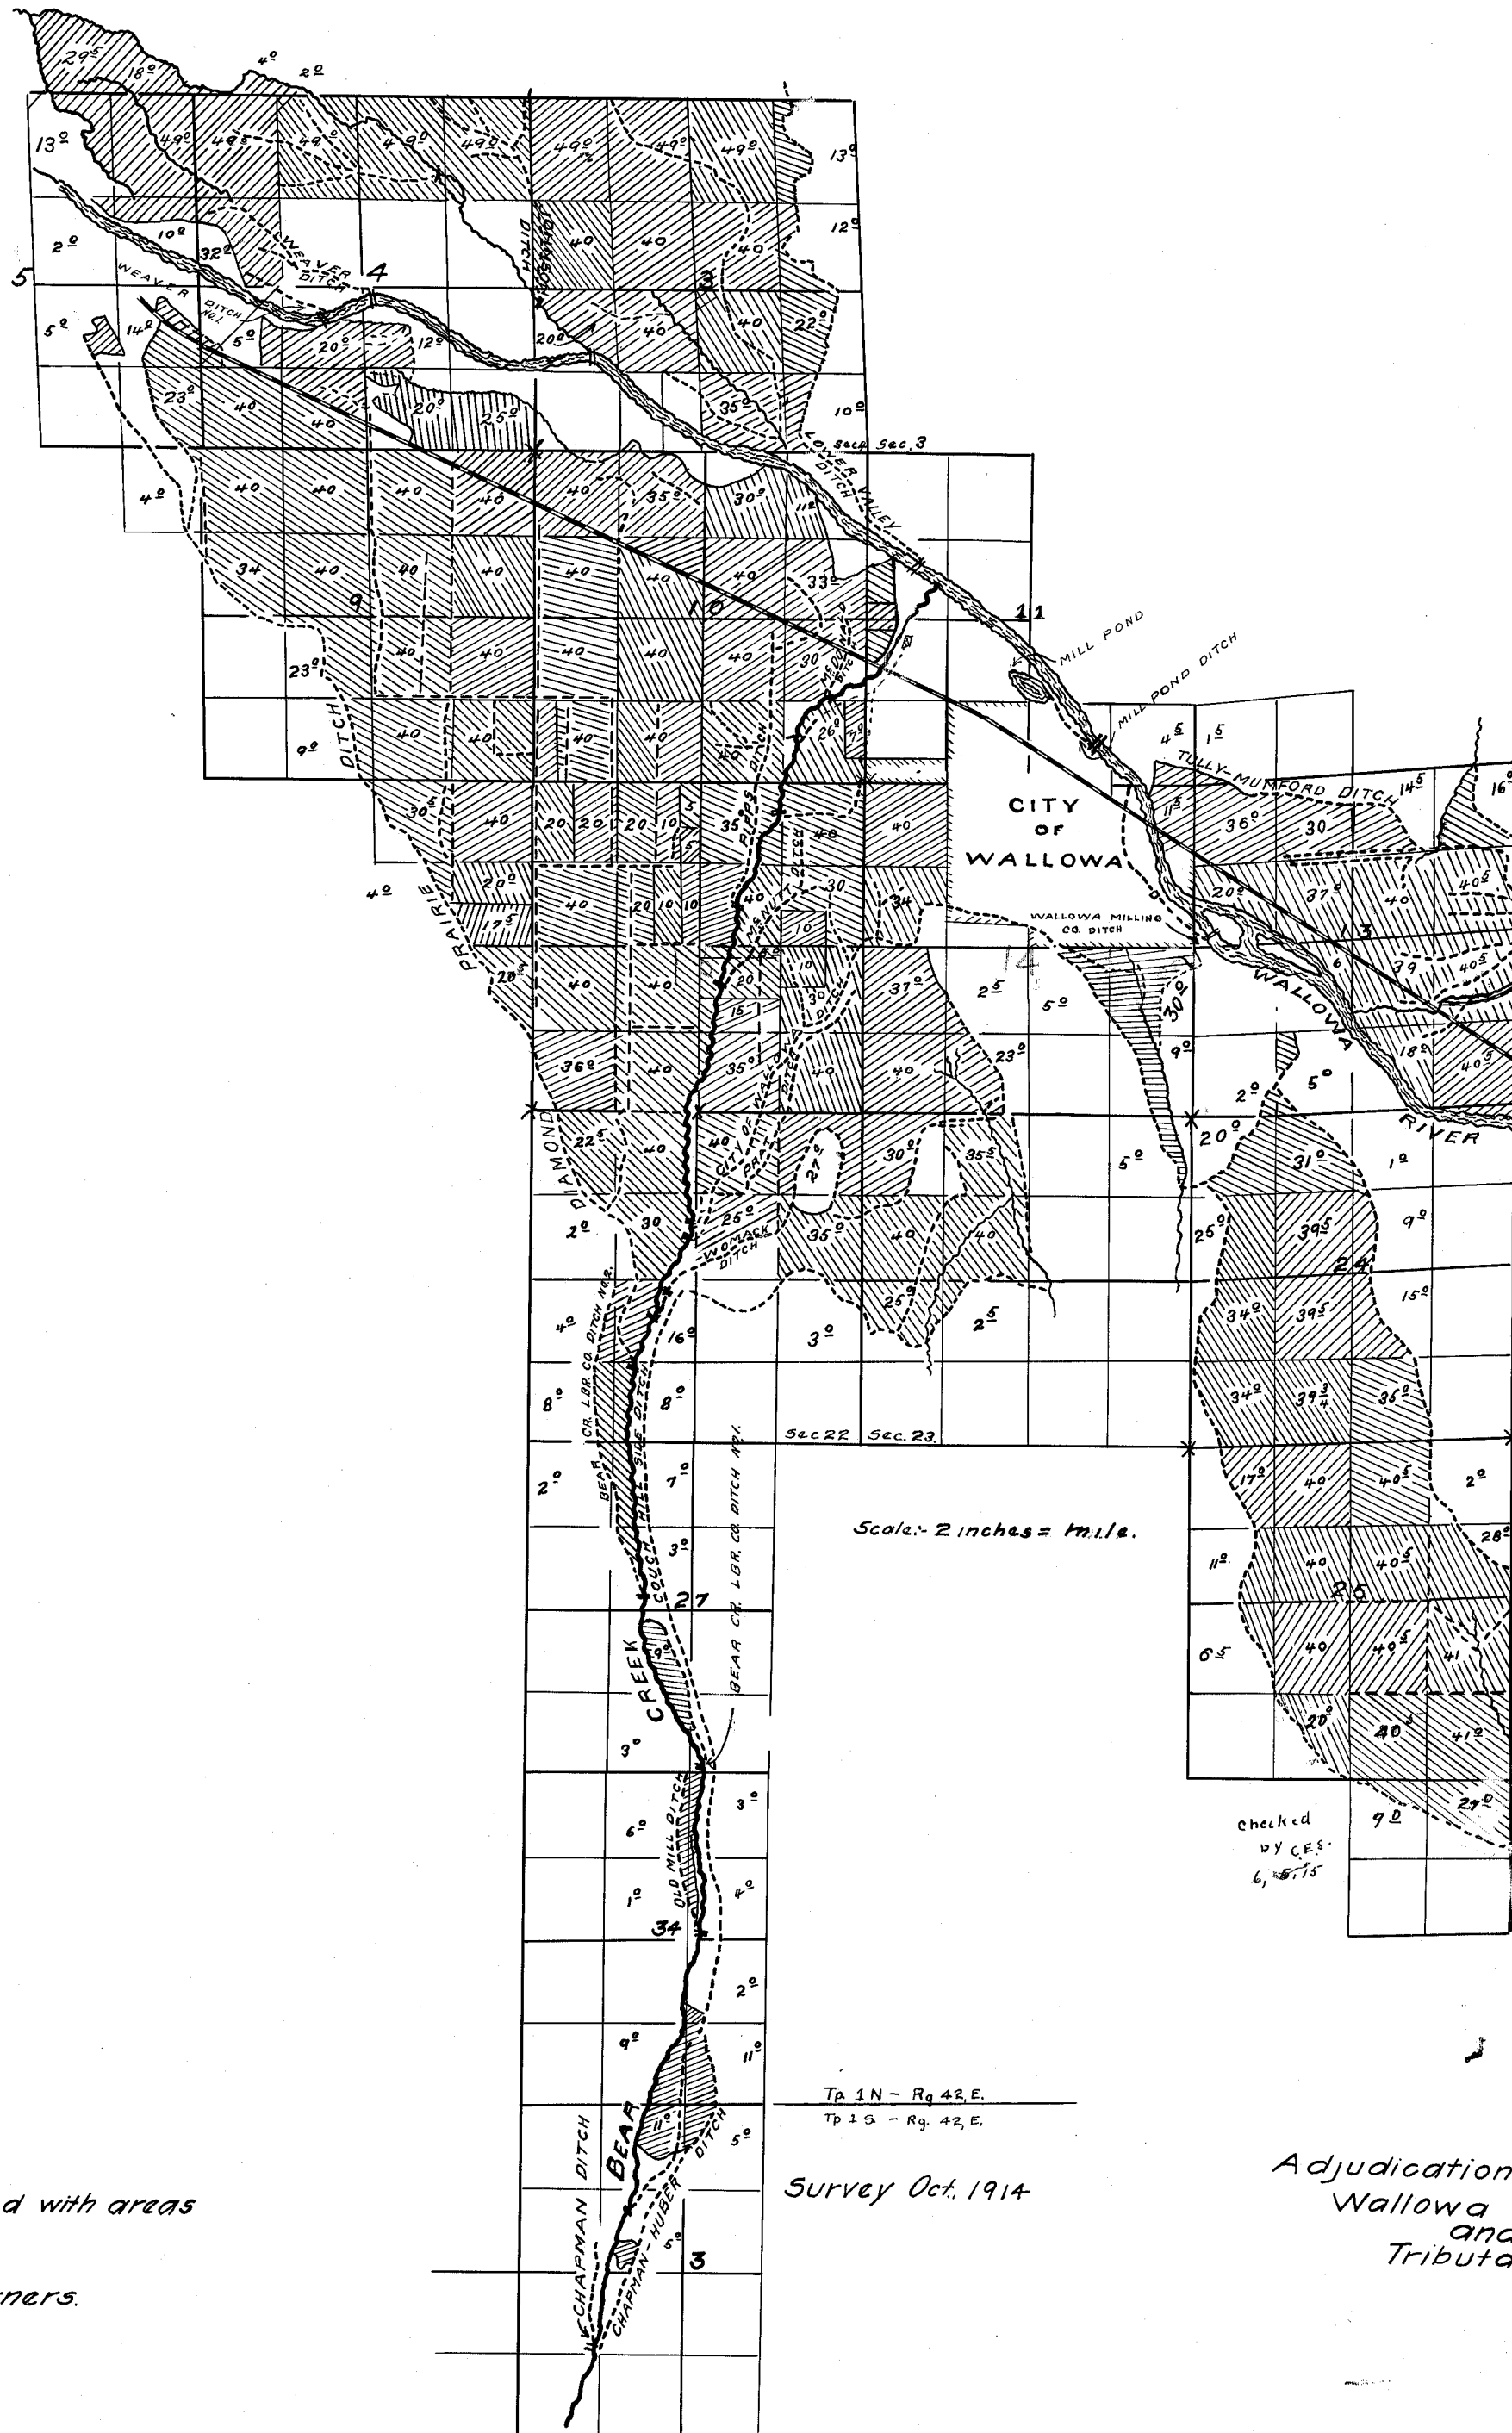

-  Irrigated land with areas
-  Ditches.
-  Streams.
-  Located corners.

Scale: 2 inches = 1 mile.

Tp 1 N - Rg 42 E.  
Tp 1 S - Rg 42 E.

Survey Oct. 1914

Adjudication Survey  
Wallowa River  
and  
Tributaries.

Checked  
by C.E.S.  
6, 5, 7, 5