


C7272

Form 974.

T. 13 S. R. 9 E. Willamette Mer.

10383

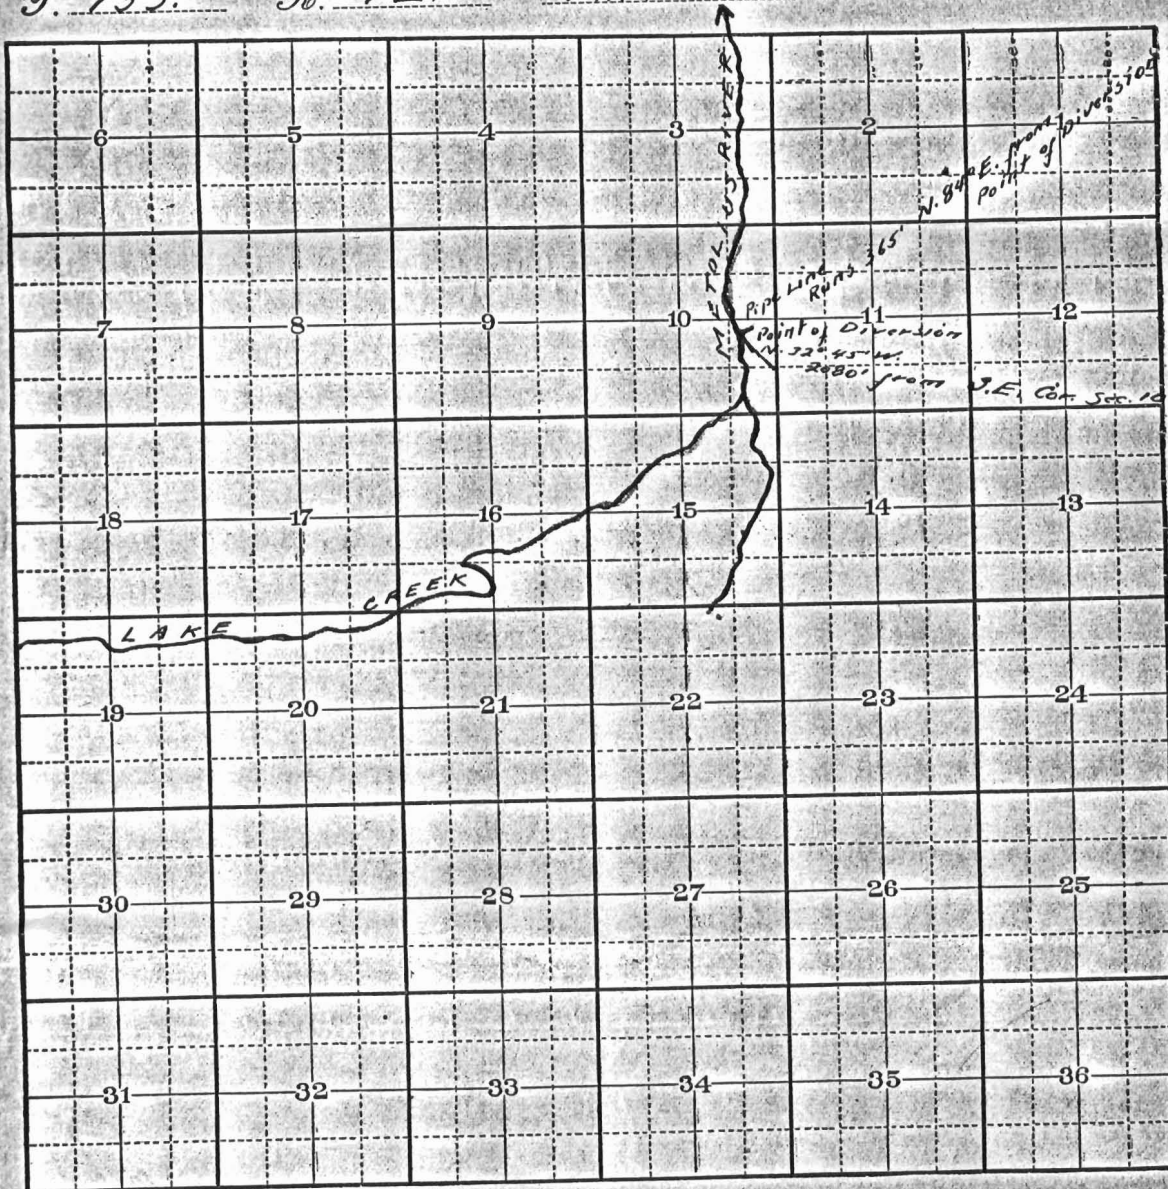

True Meridian.

8-257

SCALE.—One inch = 1 mile.

STATE ENGINEER
RECEIVED

SEP 11 1925

SALEM,

OREGON

Application No. 10383
Permit No. 6918 #1

STATE ENGINEER
WATER RESOURCES DEPARTMENT
SALEM

December 27th, 1923.

Mr. B. F. Madsen,
Camp Sherman, Jefferson Co.,
Oregon.

Dear Sir:-

Upon taking up for approval your Application No. 9292 for permit to appropriate water from Cold Spring for domestic purposes, I note you have not indicated in the application the location of the termination of the pipeline or ditch through which the water is to be carried, and I am unable to determine from the map the exact location of the ditch or pipeline, or the place where the water will be used for domestic purposes. I am, therefore, returning the map and application herewith for correction in this respect.

I would also be glad if you would make a statement in the application as to the manner of diverting the water from the spring.

In order to retain its original date of priority the application should be corrected and returned to this office with the required map, on or before January 27th, 1924.

Yours respectfully,

Rhea Luper
Rhea Luper
State Engineer.

ER-LA

State Engineer

Camp Sherman Jan 3rd 24

Dear Sir:

There is no ditch or pipe line as the spring is close to the house and I dip it up with a pail, and the spring goes through my barn yard where the stock drink.

yours Truly

B. F. Madsen

#2

6918