


RECEIVED
281

FINAL PROOF SURVEY T.41S., R.13W., W.M.

SCALE: 1" = 1320 FEET

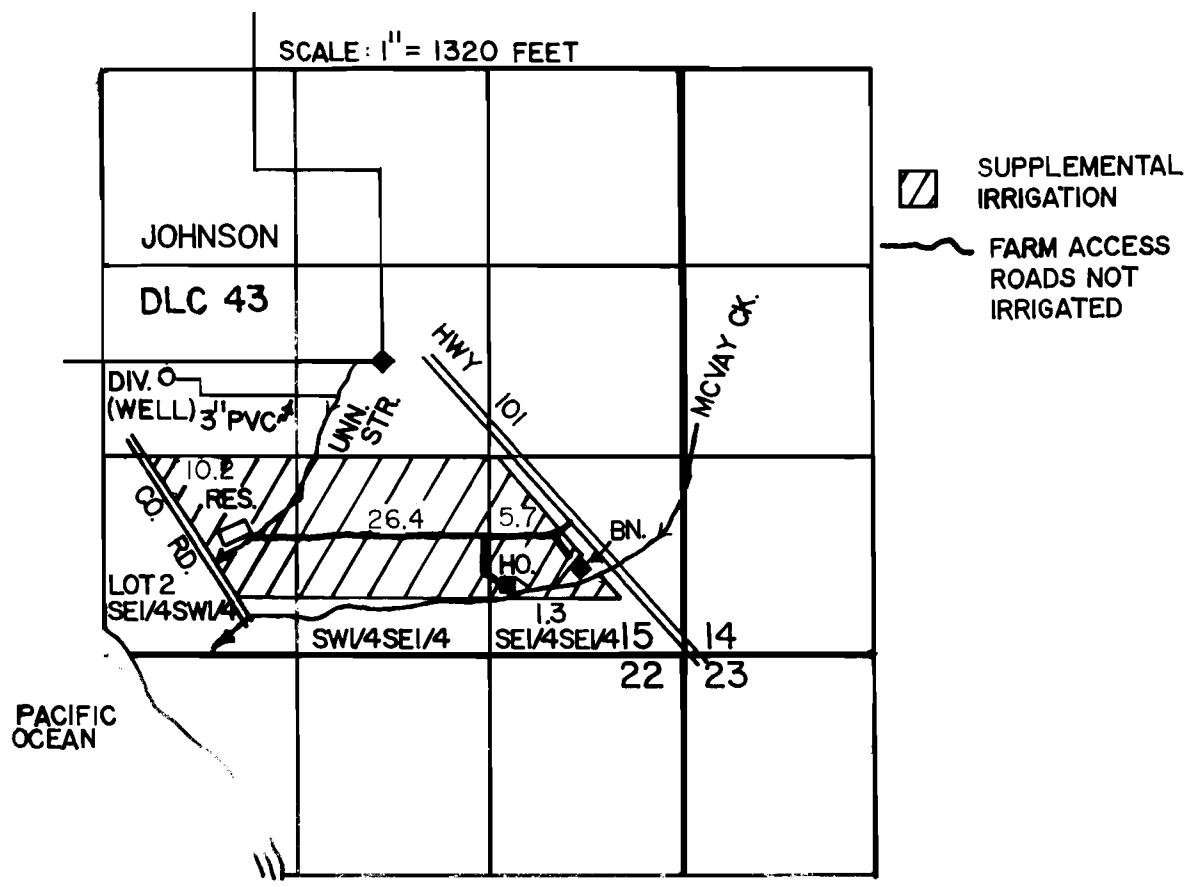

WELL, DIV. LOC. 94.6' S. & 1481.6' W. FROM SE CORNER DLC 43

APPLICATION NO. G-11905 PERMIT NO. G-11008
IN THE NAME OF CAROL L. CROCKETT
SURVEYED 6/89 BY THOMAS J. HOWIE, WRE 070
FINAL PROOF INSPECTION 3/92.

THIS MAP SHOWS THE LOCATION OF A WATER RIGHT ONLY AND HAS NO INTENTION TO PROVIDE DIMENSIONS OR LOCATION OF PROPERTY OWNERSHIP LINES.

