
 






Dexter Lake

LANE COUNTY, OREGON

U.S. Army Engineer District
Corps of Engineers Portland, Oregon

SIGNIFICANT PROJECT FEATURES

-  Dexter Dam
-  Maximum Conservation Pool
(Elev. (693.4 ft.)
15 June 1988 (883.66 Surface Acres)
-  USCE Control
-  Found $\frac{1}{4}$ Corner
-  Not found $\frac{1}{4}$ Corner
-  State Route




FINAL PROOF SURVEY


APPLICATION NO. R-29397

PERMIT NO. R-1625

INSPECTED19.....

BY

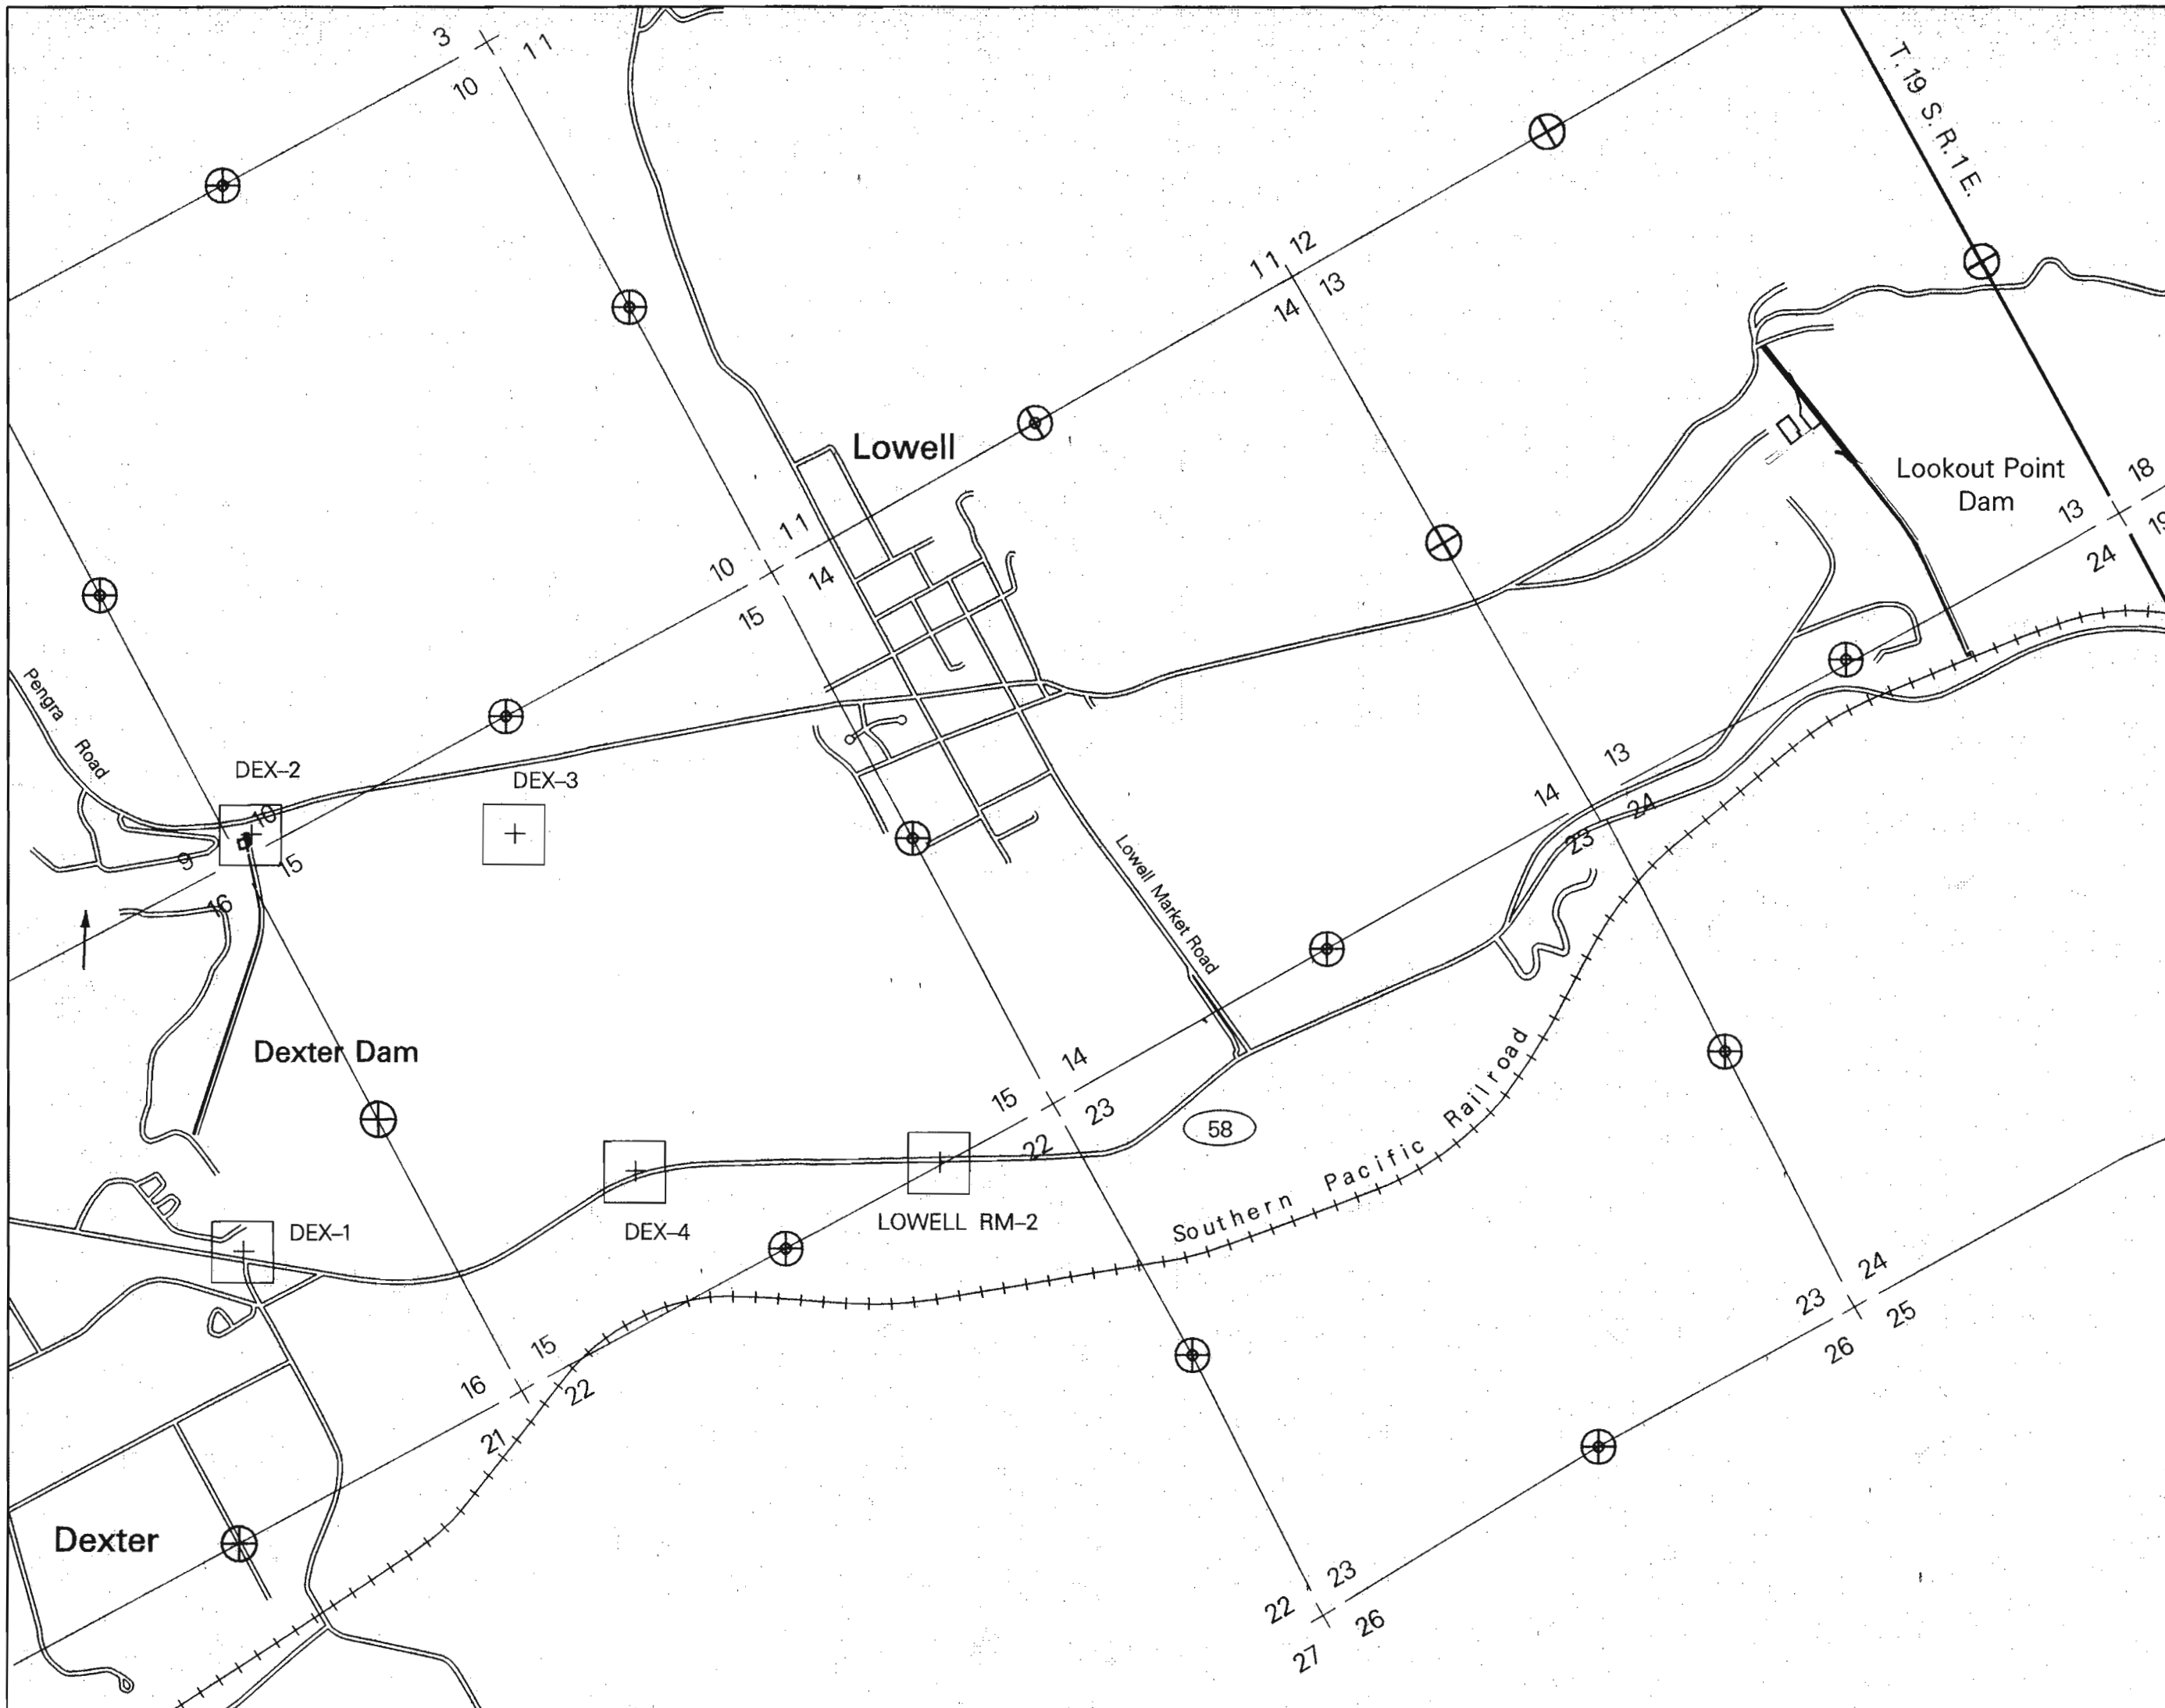

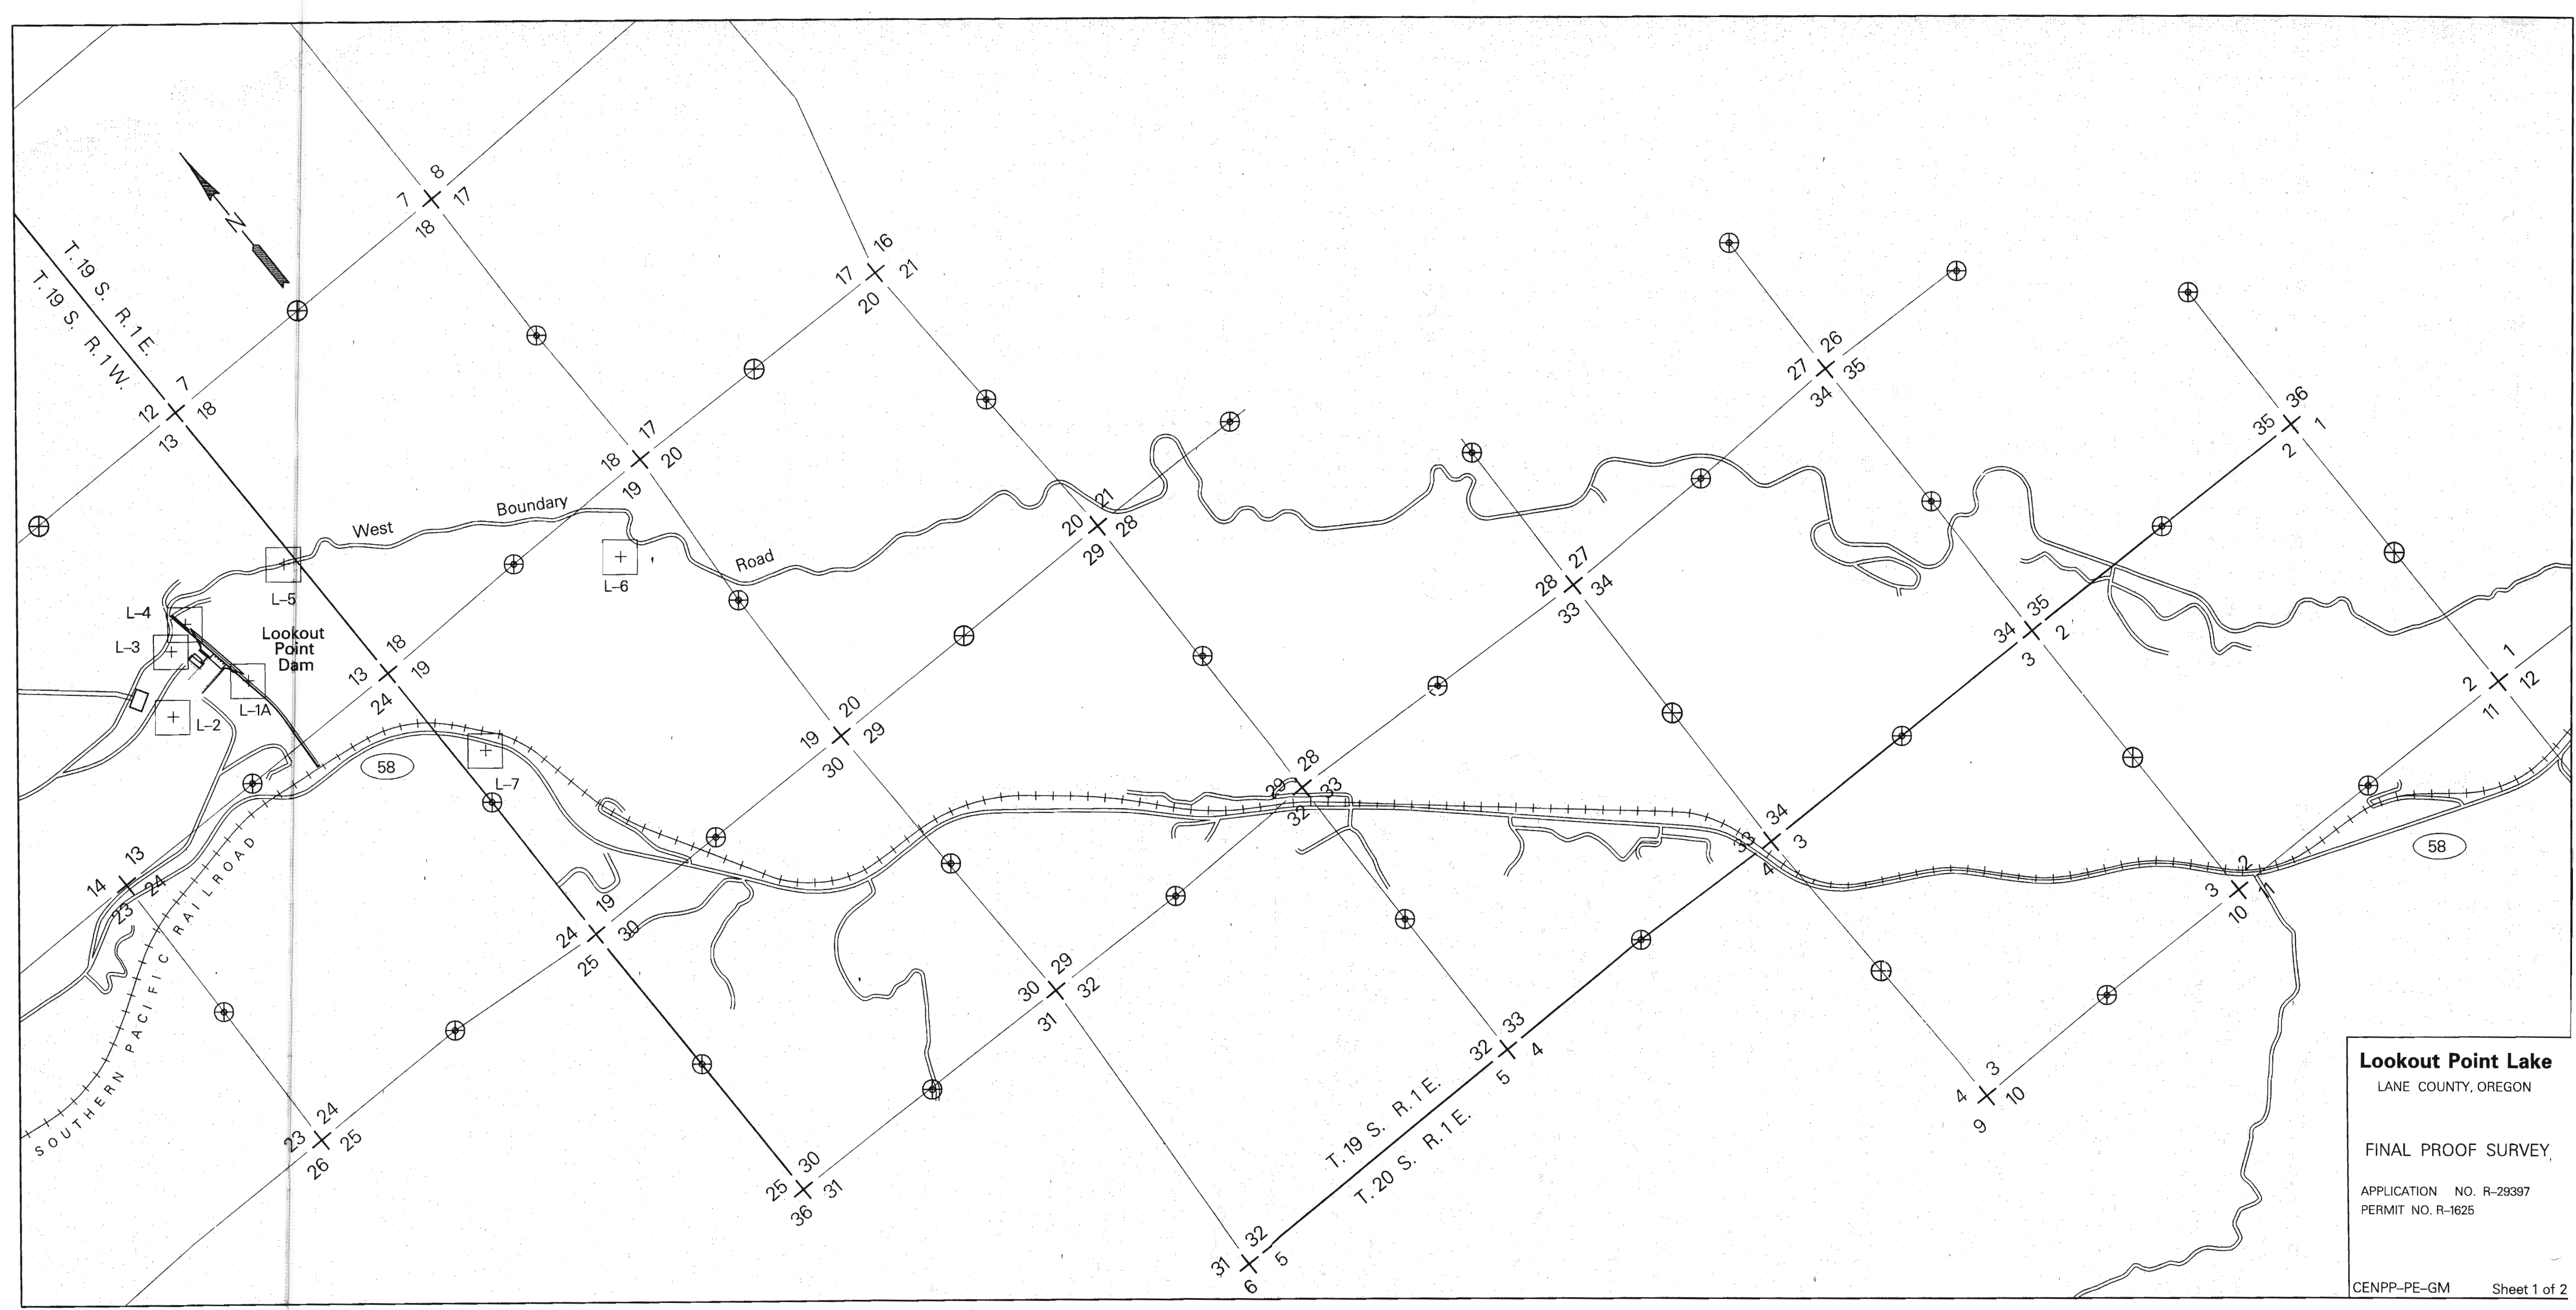

Lookout Point Lake
LANE COUNTY, OREGON

FINAL PROOF SURVEY







APPLICATION NO. R-29397
PERMIT NO. R-1625

Lookout Point Lake

LANE COUNTY, OREGON

U.S. Army Engineer District
Corps of Engineers Portland, Oregon

SIGNIFICANT PROJECT FEATURES

-  Lookout Point Dam
-  Maximum Conservation Pool
(Elev. 926.27 ft.)
15 June 1988 (4,139.46 Surface Acres)
-  USCE Control
-  Found $\frac{1}{4}$ Corner
-  Not found $\frac{1}{4}$ Corner
-  State Route





FINAL PROOF SURVEY

APPLICATION NO. R29397
PERMIT NO. R-1625



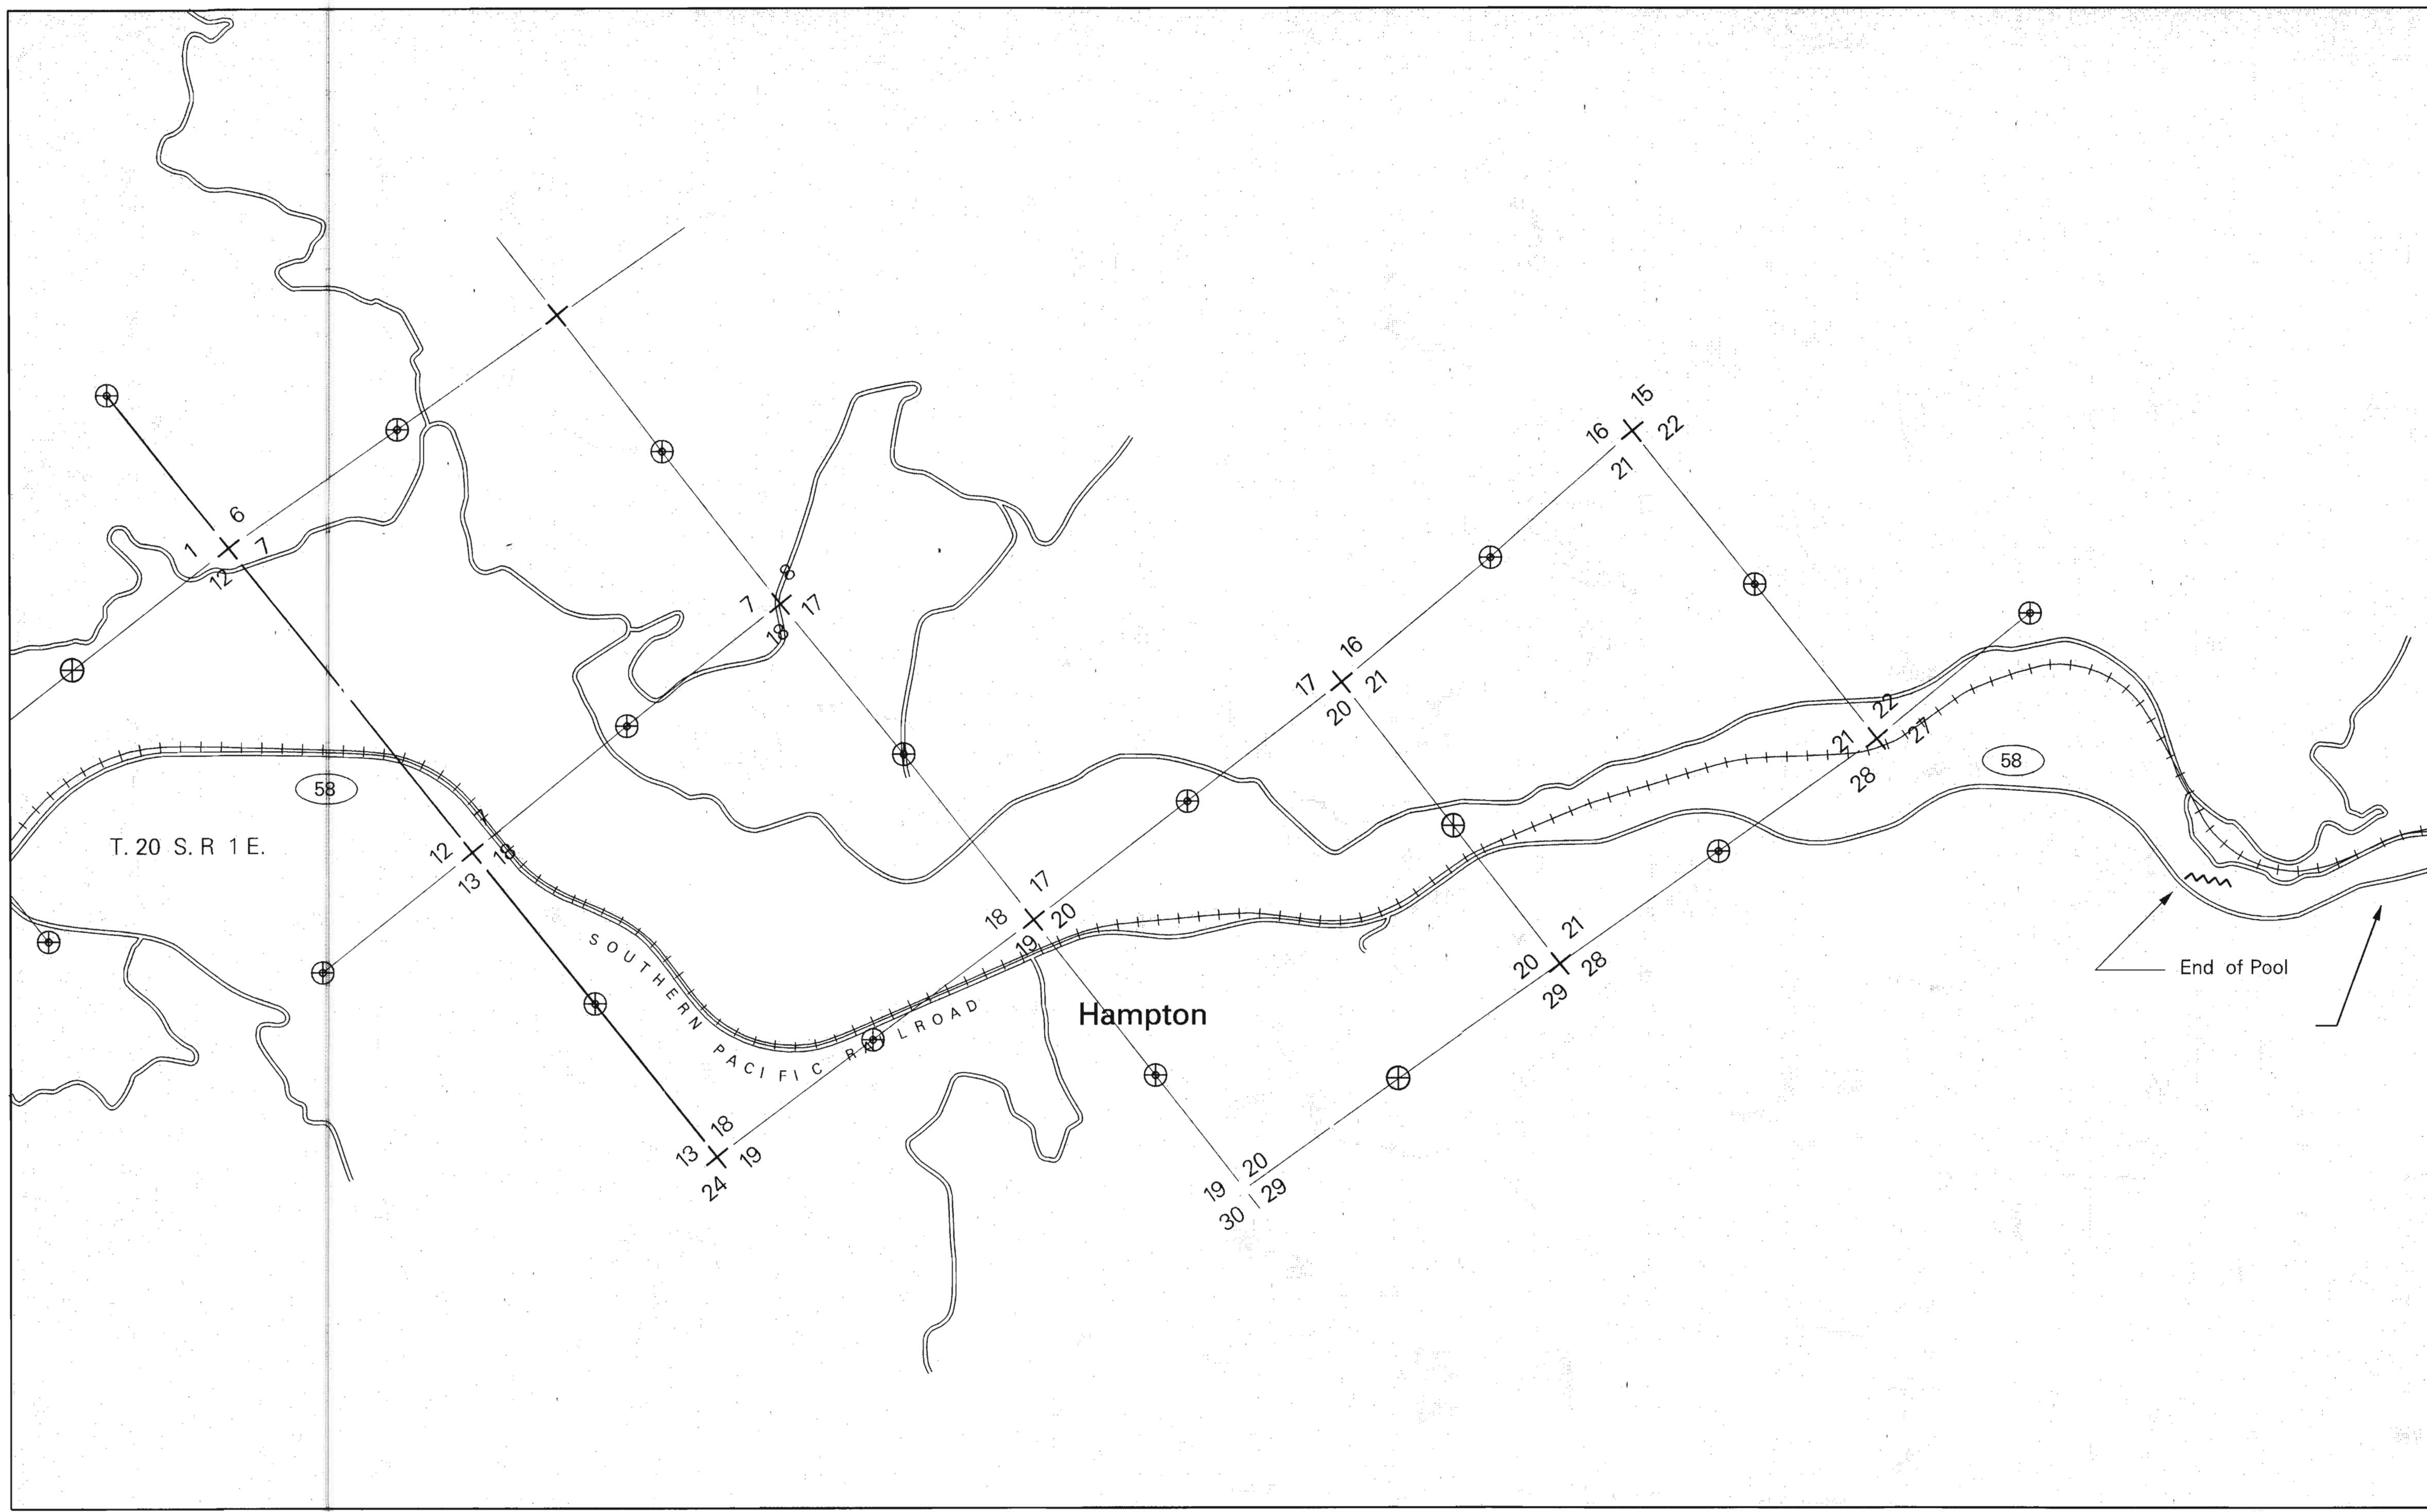



INSPECTED 19

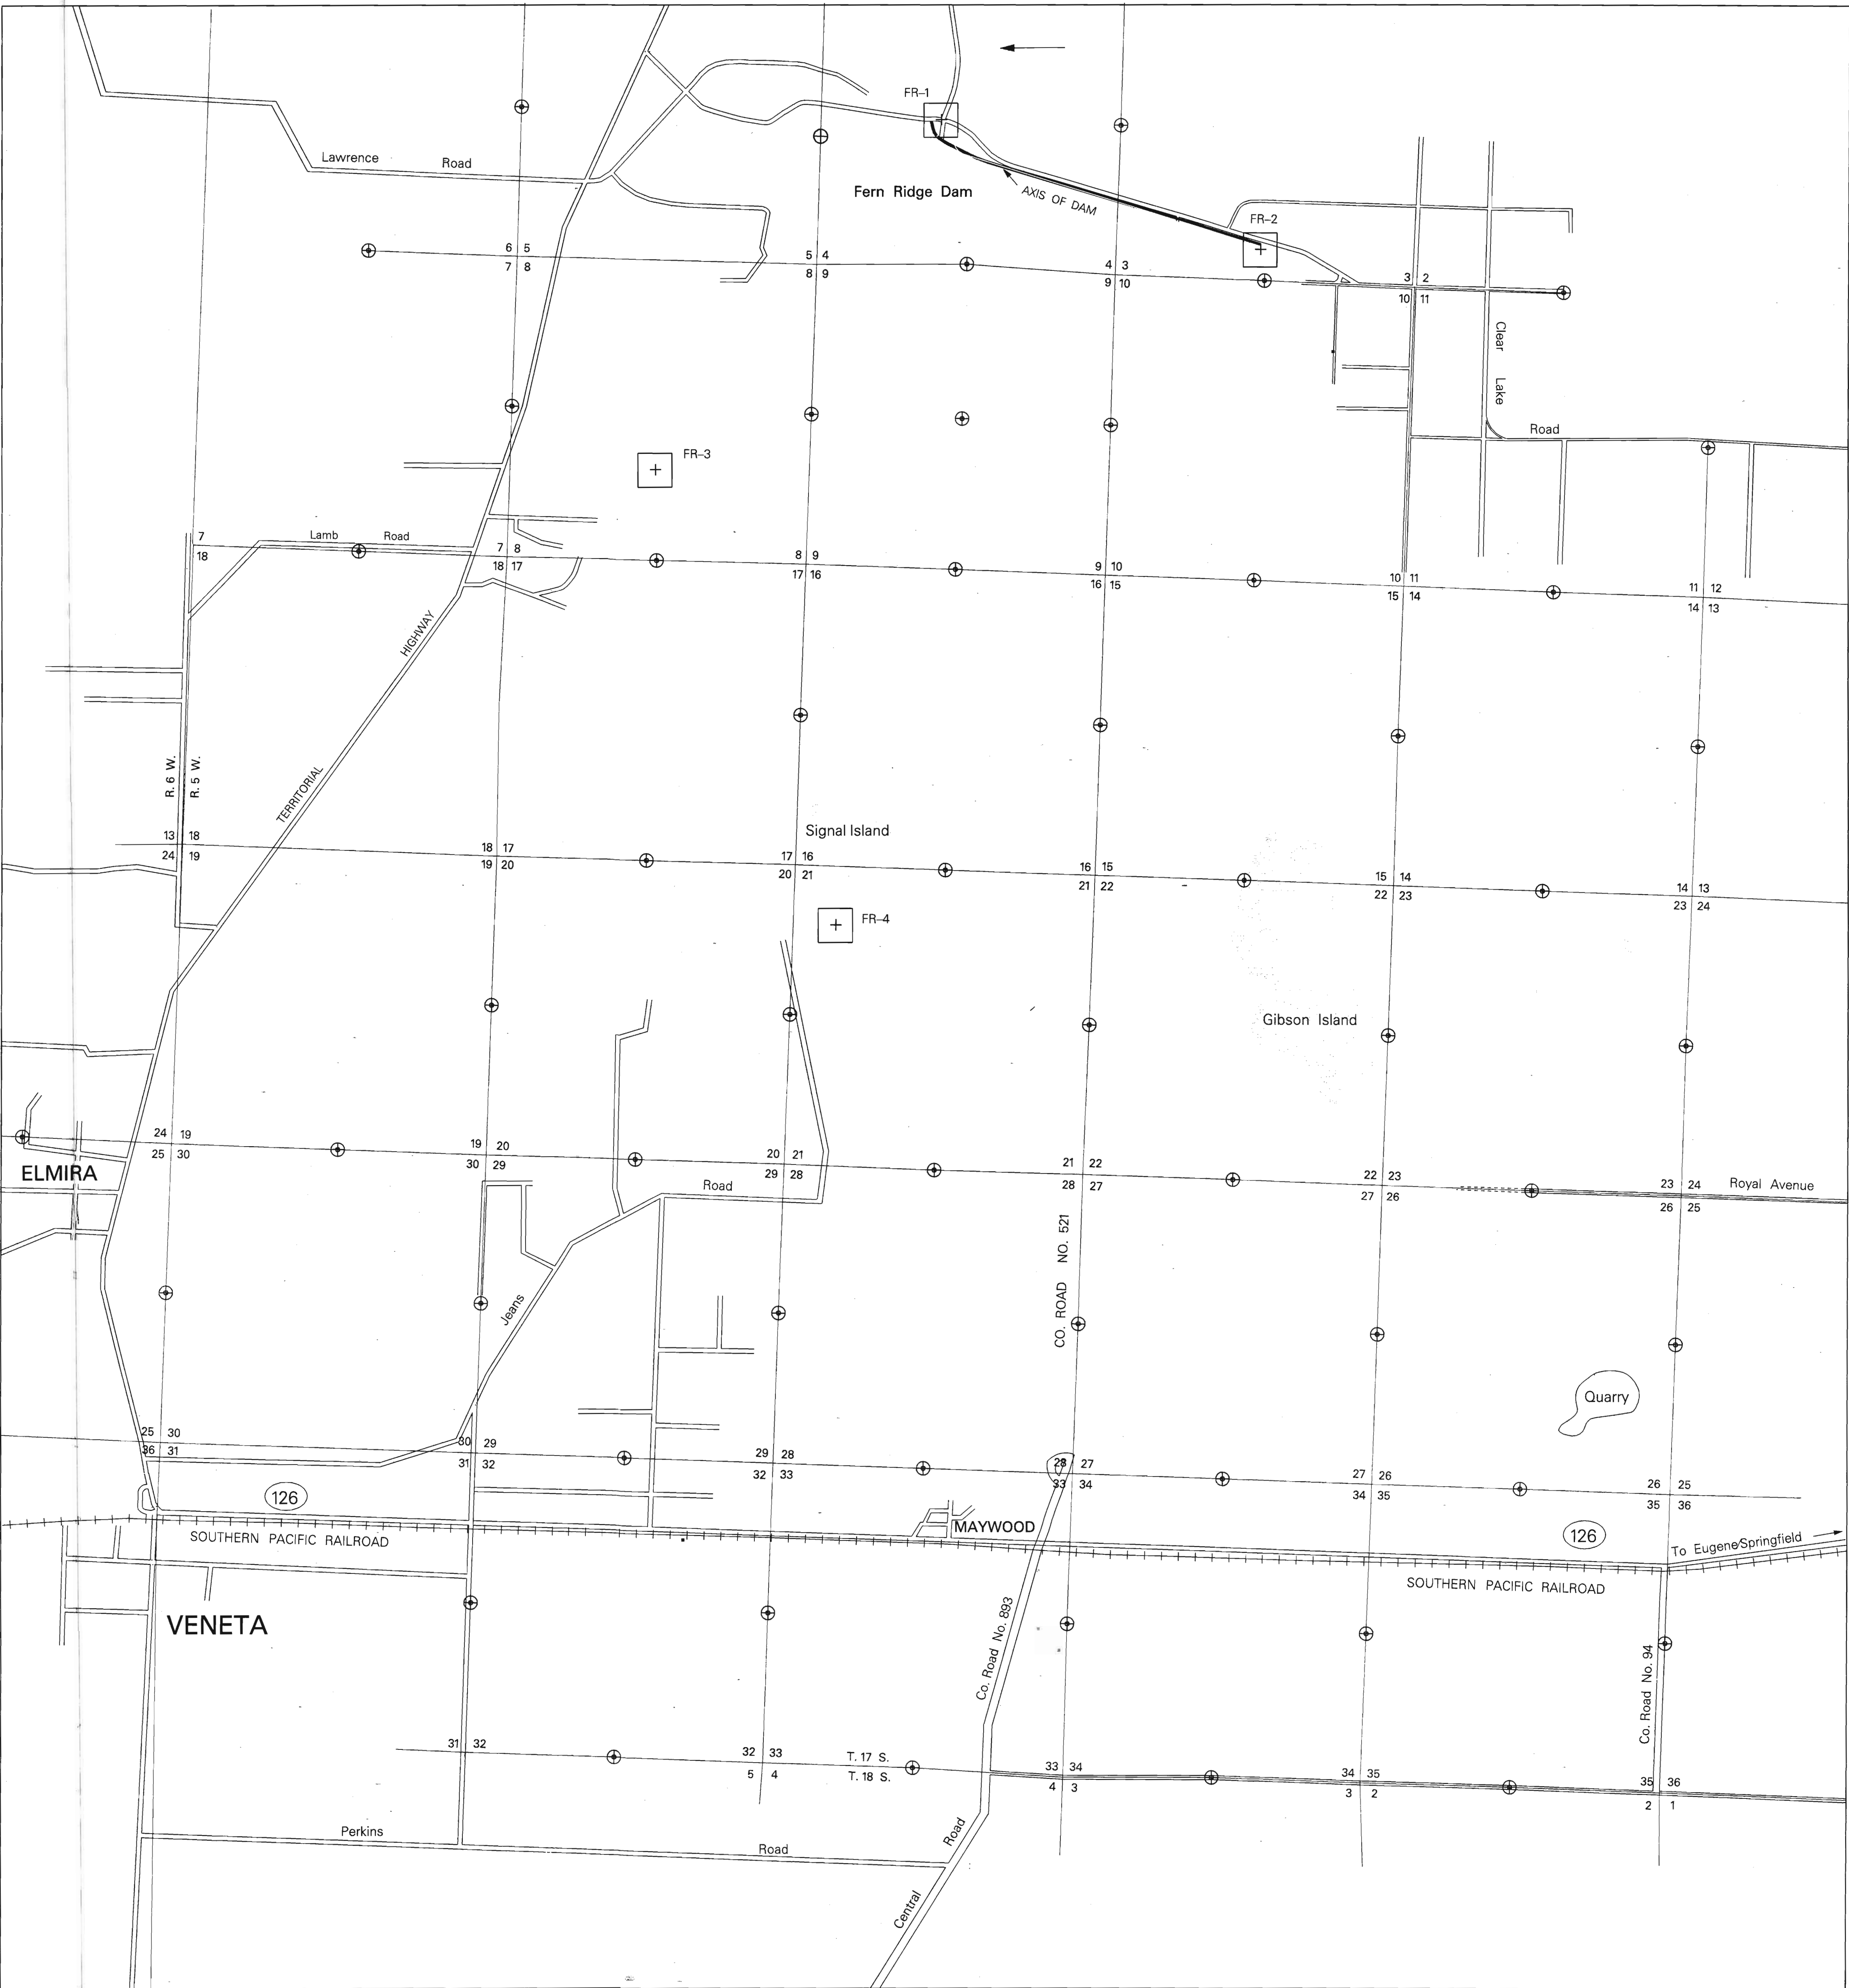
BY



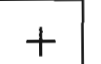

SIGNIFICANT PROJECT FEATURES

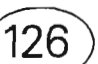-  Fern Ridge Dam
-  Maximum Conservation Pool (Elev. 373.51 ft.)
31 May 1991 (7,752.53 Surface Acres)
-  USCE Control
-  Found $\frac{1}{4}$ Corner
-  Not found $\frac{1}{4}$ Corner
-  State Route

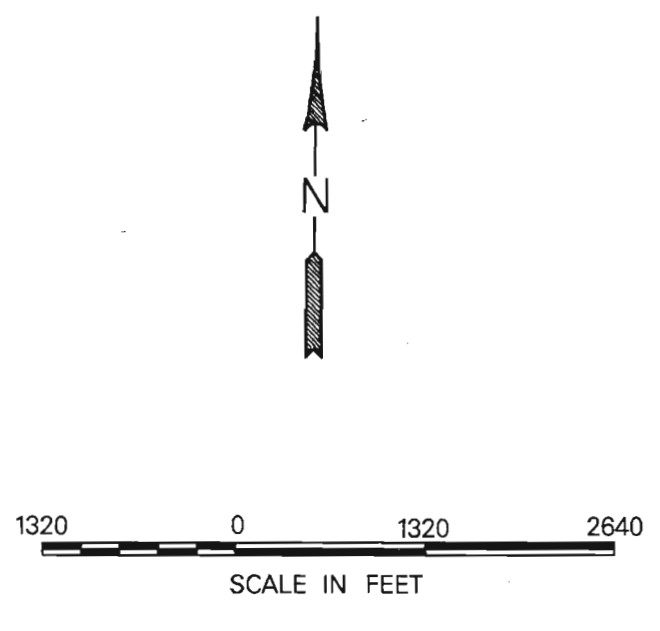

Fern Ridge Lake

LANE COUNTY, OREGON

U. S. Army Engineer District
Corps of Engineers Portland, Oregon

FINAL PROOF SURVEY
APPLICATION NO. R-29397
PERMIT NO. R-1625

INSPECTED 19.....

BY