



THIS MAP WAS PREPARED FOR THE PURPOSE OF IDENTIFYING
THE LOCATION OF THE WATER RIGHT AND IS NOT INTENDED
TO PROVIDE LEGAL DIMENSIONS OR LOCATIONS OF PROPERTY
OWNERSHIP LINES.

T4S; R48E; W.M.

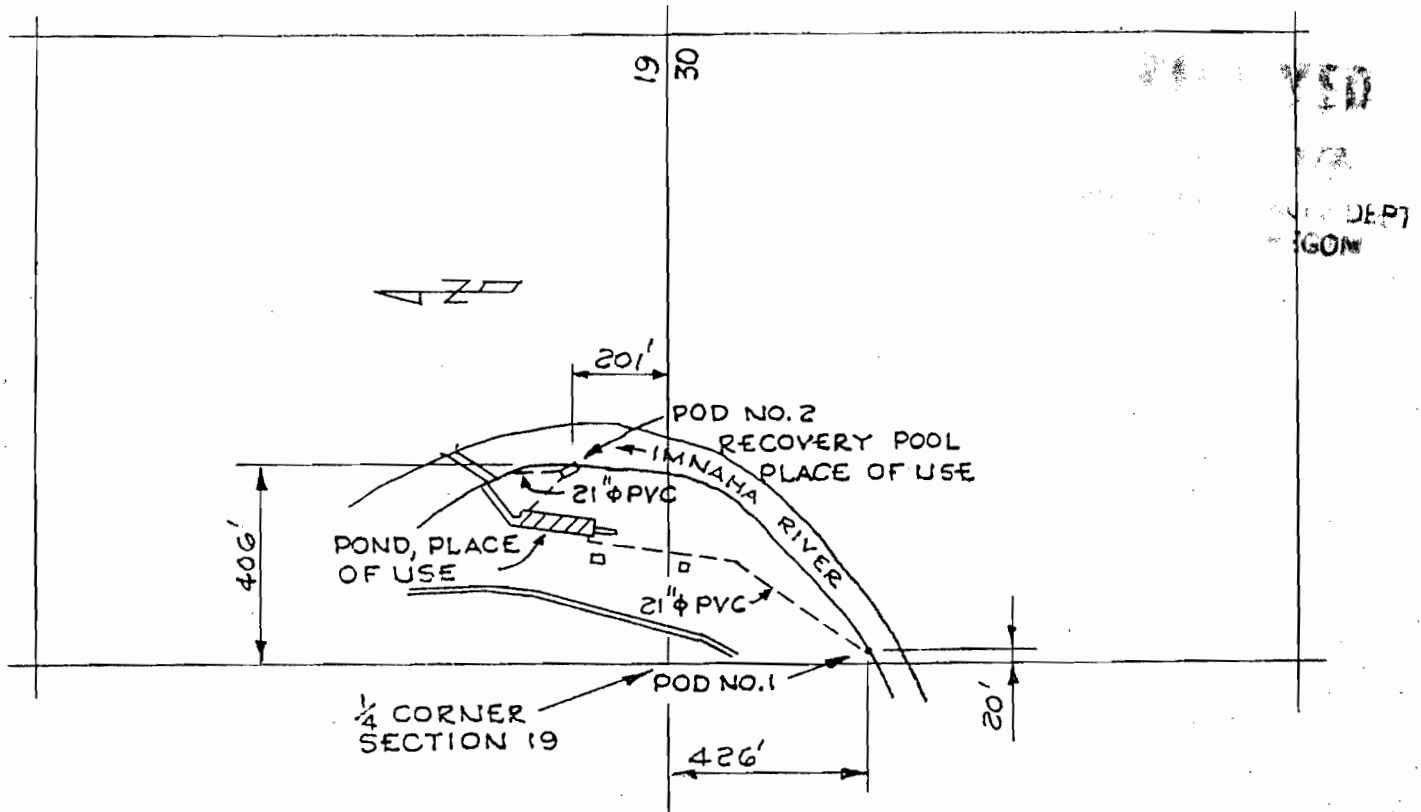

SCALE 1" = 400'

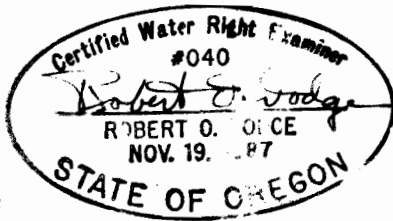

FINAL PROOF SURVEY UNDER

APPLICATION NO. 69200 PERMIT NO. 50878
IN NAME OF

U.S. FISH AND WILDLIFE SERVICE

SURVEYED: 7/14/93 BY: DODGE