

T. 4 S., R. 5 ^W ~~S~~, W.M.

D.L.C.
46

Distances from DLC corner to dwellings:

"A" 86'E & 314'S

"B" 43'E & 458'S

"C" 39'E & 502'S

"D" 32'E & 542'S

Location: The NW 1/4 of the SW 1/4 of
Section 26 T. 4 S., R. 5 W., W.M.,
Yamhill County, Oregon

Scale: 1" = 400'

D.L.C.
47

Iron pipe & brass cap
NW cor. DLC No. 53 Yamhill
County

Unnamed Spring

care
center
"A"

overflow ditch

N 77°30' W


OWEN D.L.C. No. 53

house "B"

duplex "C"

house "D"

F.V. 95 Page 1008

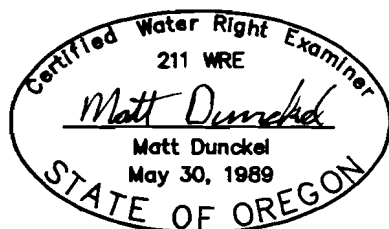

LEGEND:

- = Property line
- - - = D.L.C. line
- = Section line
- = "40" line

By: Matt Dunckel & Assoc.
19010 Baker Creek Road
McMinnville, OR 97128
Phone: 472-7904

YOUNGBERG HILL ROAD

FINAL PROOF SURVEY UNDER

Application No. 69277 Permit No. 50175

IN NAME OF

Rock of Ages Mennonite Home

Surveyed 2 Dec., 1992

1191