


Township 7 South, Range 5 West, W.M.  
 Portions of Sections 30 and 31

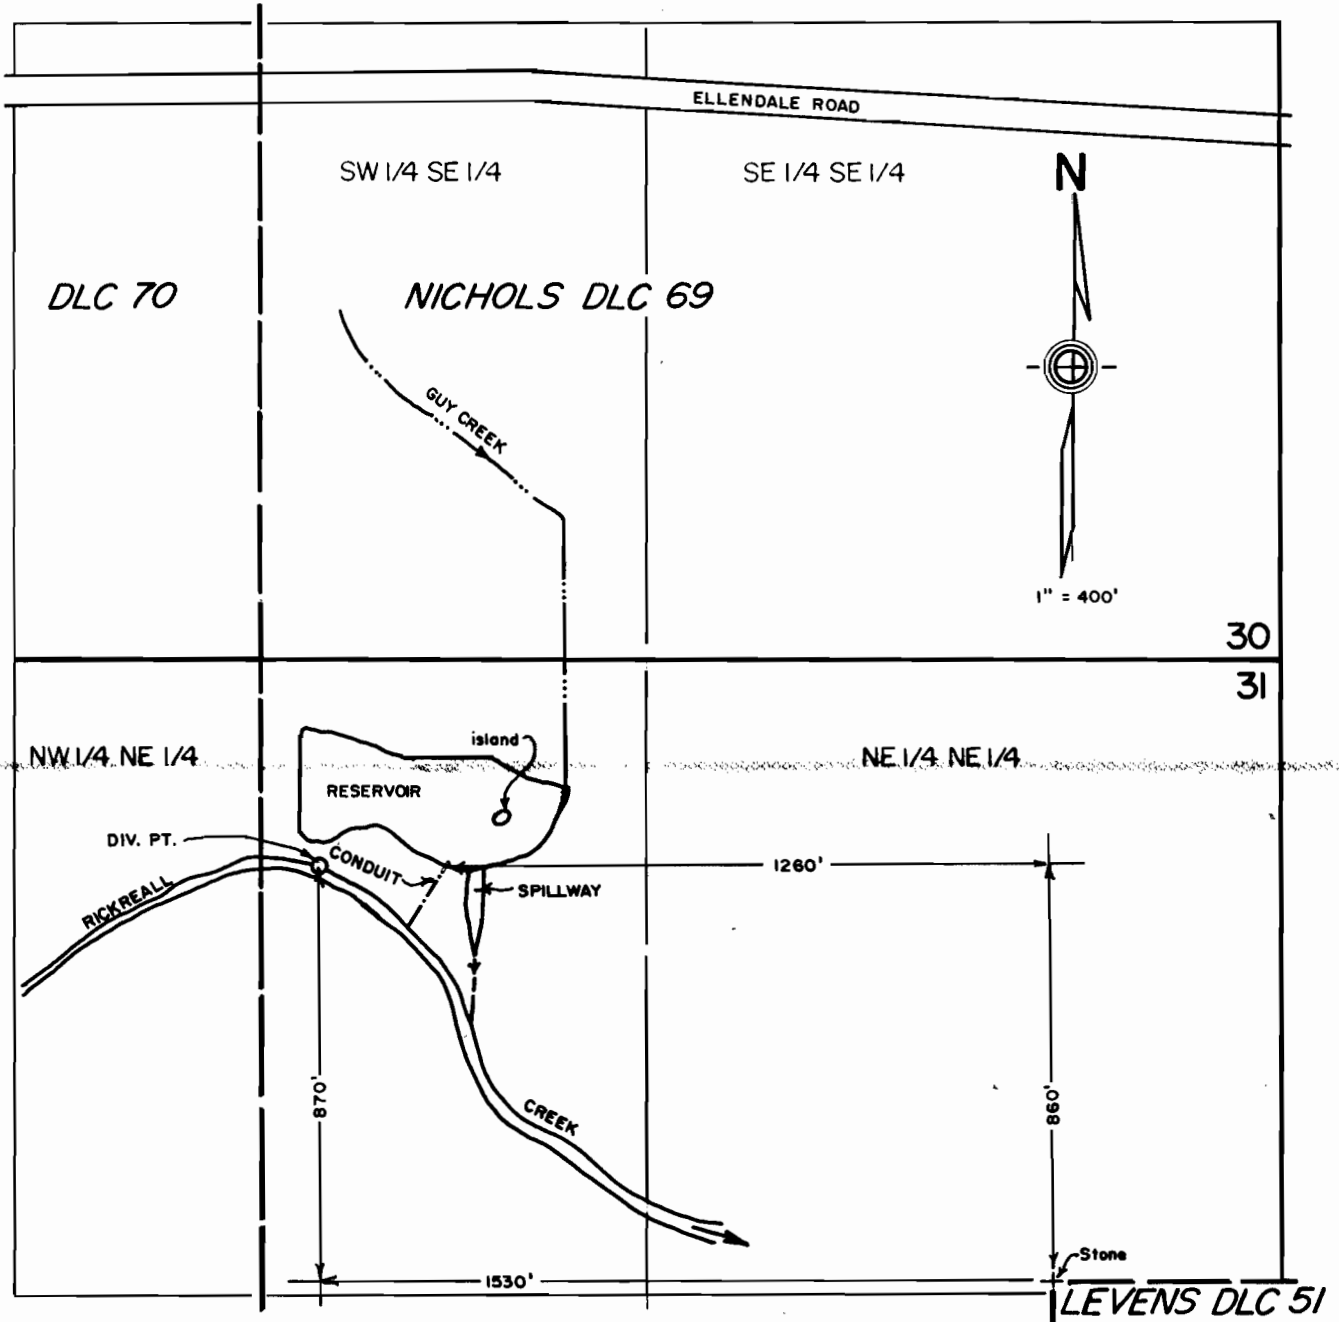

FINAL PROOF SURVEY  
 under  
 Appl's. R-70085, Per's. R-11194  
 70086 50854  
 in name of  
**STEPHEN F. MANNENBACH**  
 September 26, 1992



THIS MAP WAS PREPARED FOR THE PURPOSE OF IDENTIFYING THE LOCATION OF A WATER RIGHT ONLY AND IS NOT INTENDED TO PROVIDE LEGAL DIMENSIONS OR LOCATION OF PROPERTY OWNERSHIP LINES.