



Township 7 South, Range 5 West, W.M.  
Portions of Sections 30 and 31

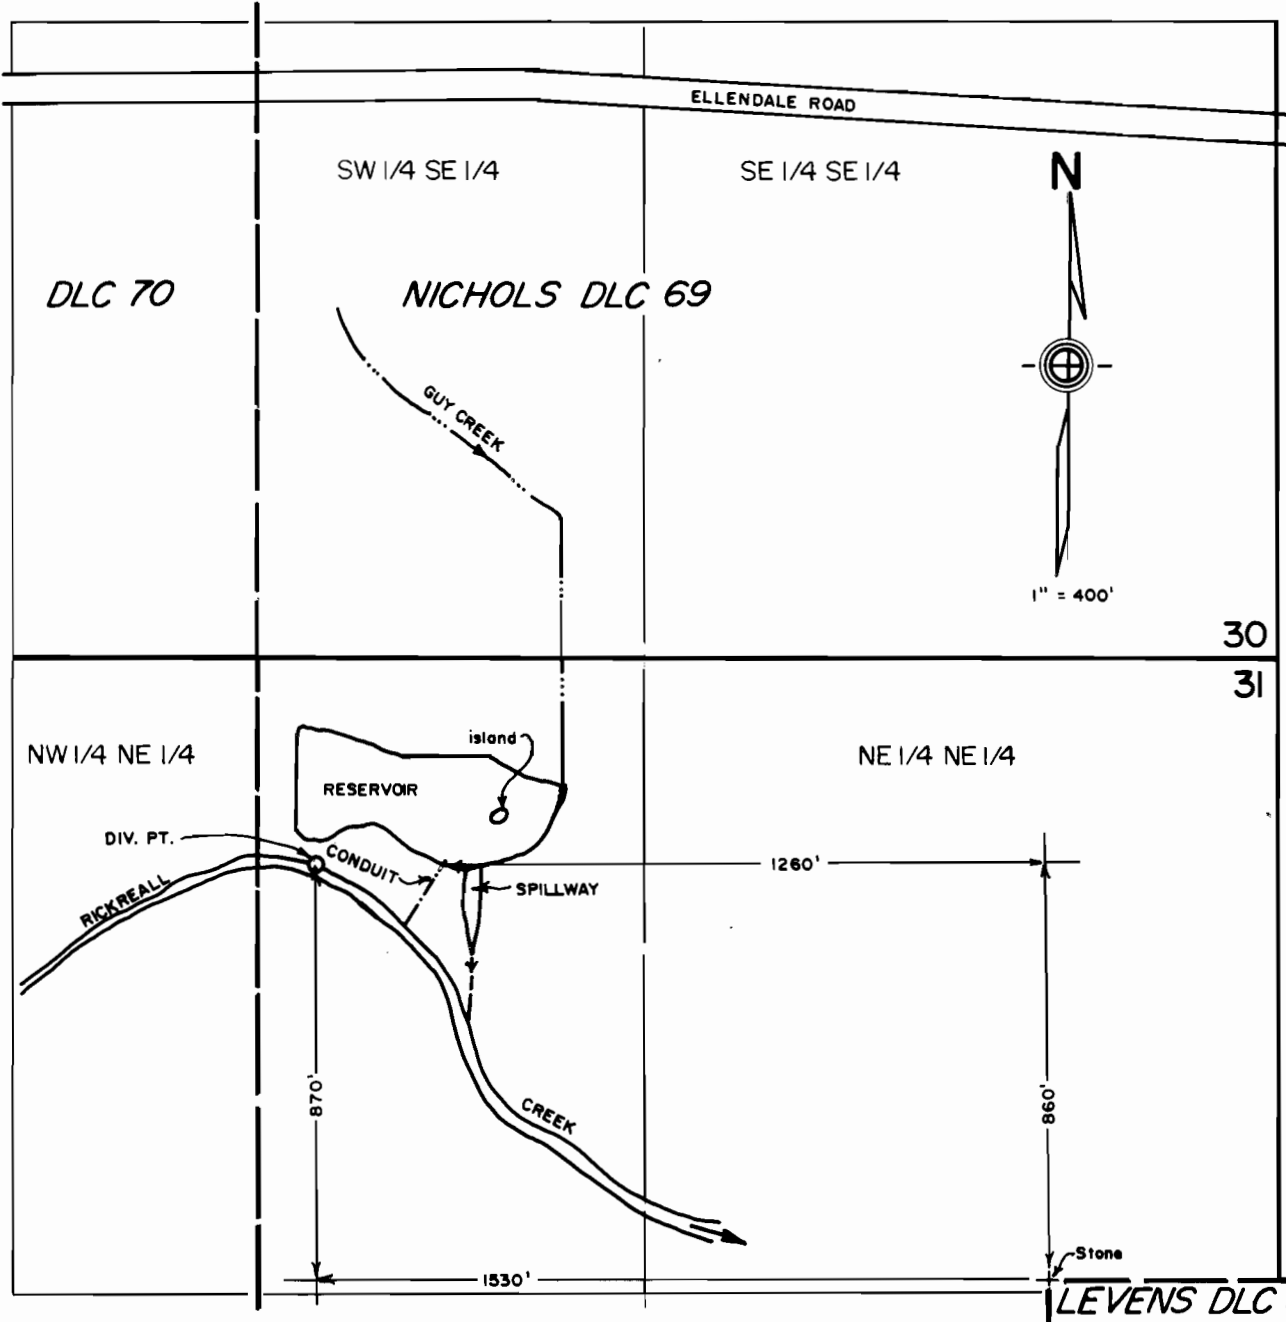

FINAL PROOF SURVEY  
under  
Appl's. R-70085, Per's. R-11194  
70086 50854  
in name of  
STEPHEN F. MANNENBACH  
September 26, 1992

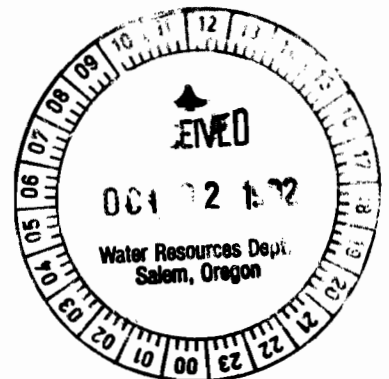

THIS MAP WAS PREPARED FOR THE PURPOSE OF IDENTIFYING THE LOCATION OF A WATER RIGHT ONLY AND IS NOT INTENDED TO PROVIDE LEGAL DIMENSIONS OR LOCATION OF PROPERTY OWNERSHIP LINES.