

RECEIVED

NOV 19 1987
WATER RESOURCES DEPT
DOUGLAS COUNTY


FINAL PROOF SURVEY MAP

IN THE NAME OF JOHN VERBERKMOES

SECTIONS 12 & 13, TOWNSHIP 28 SOUTH, RANGE 5 WEST, W.M.

APPLICATION 70141

PERMIT 50965

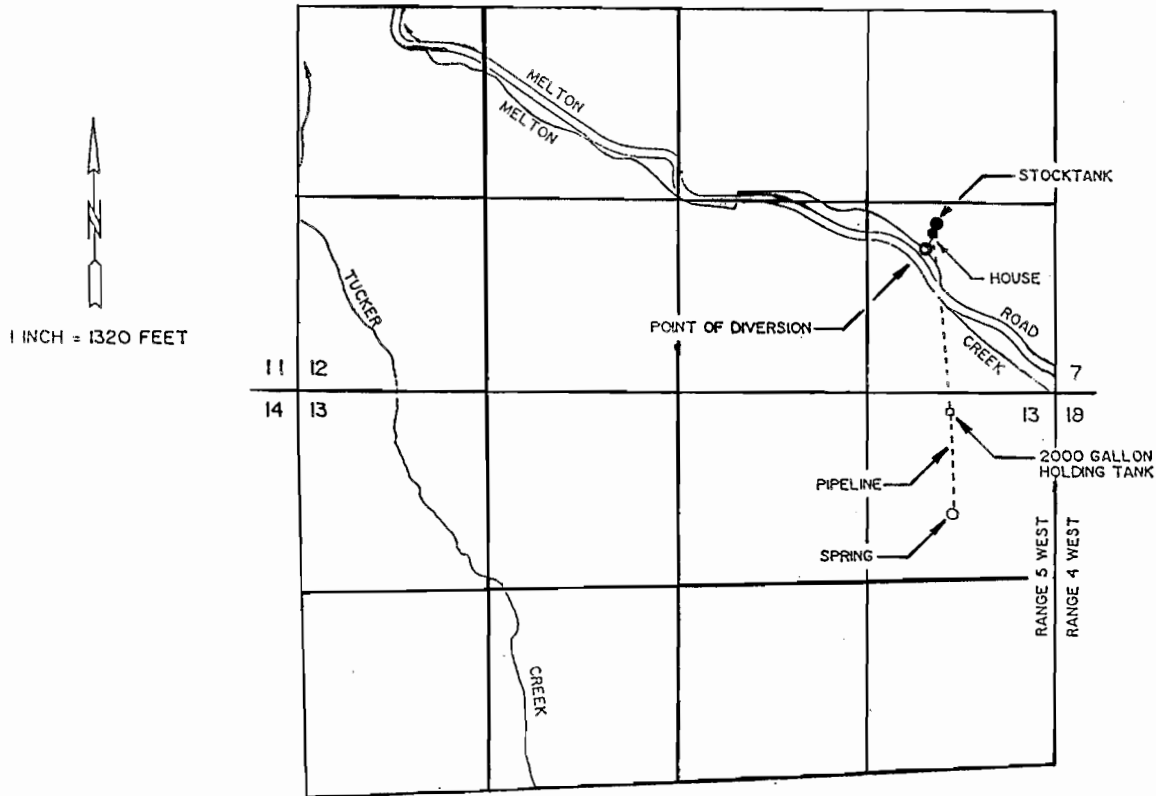

Certified Water Right Examiner
#054 WRE
James F. Gosson
James F. Gosson
Nov. 19, 1987
STATE OF OREGON

THE POINT OF DIVERSION FROM MELTON CREEK IS LOCATED 1000 FEET NORTH AND 920 FEET WEST FROM THE NORTH-EAST CORNER OF SECTION 13, BEING WITHIN THE SE 1/4 OF THE SE 1/4 OF SECTION 12. THE SPRING IS LOCATED 830 FEET SOUTH AND 710 FEET WEST FROM THE NORTHEAST CORNER OF SECTION 12, BEING WITHIN THE NE 1/4 OF THE NE 1/4 OF SECTION 13, BOTH BEING WITHIN TOWNSHIP 28 SOUTH, RANGE 5 WEST, W.M., DOUGLAS COUNTY.

THE PURPOSE OF THIS MAP IS TO IDENTIFY THE LOCATION OF THE WATER RIGHT. IT IS NOT INTENDED TO PROVIDE INFORMATION RELATIVE TO THE LOCATION OF PROPERTY OWNERSHIP BOUNDARY LINES.