


T. 28 S., R. 11 W., W.M.

Scale: 1" = 400'

This map is not the result of a property survey and is not to be used as such.

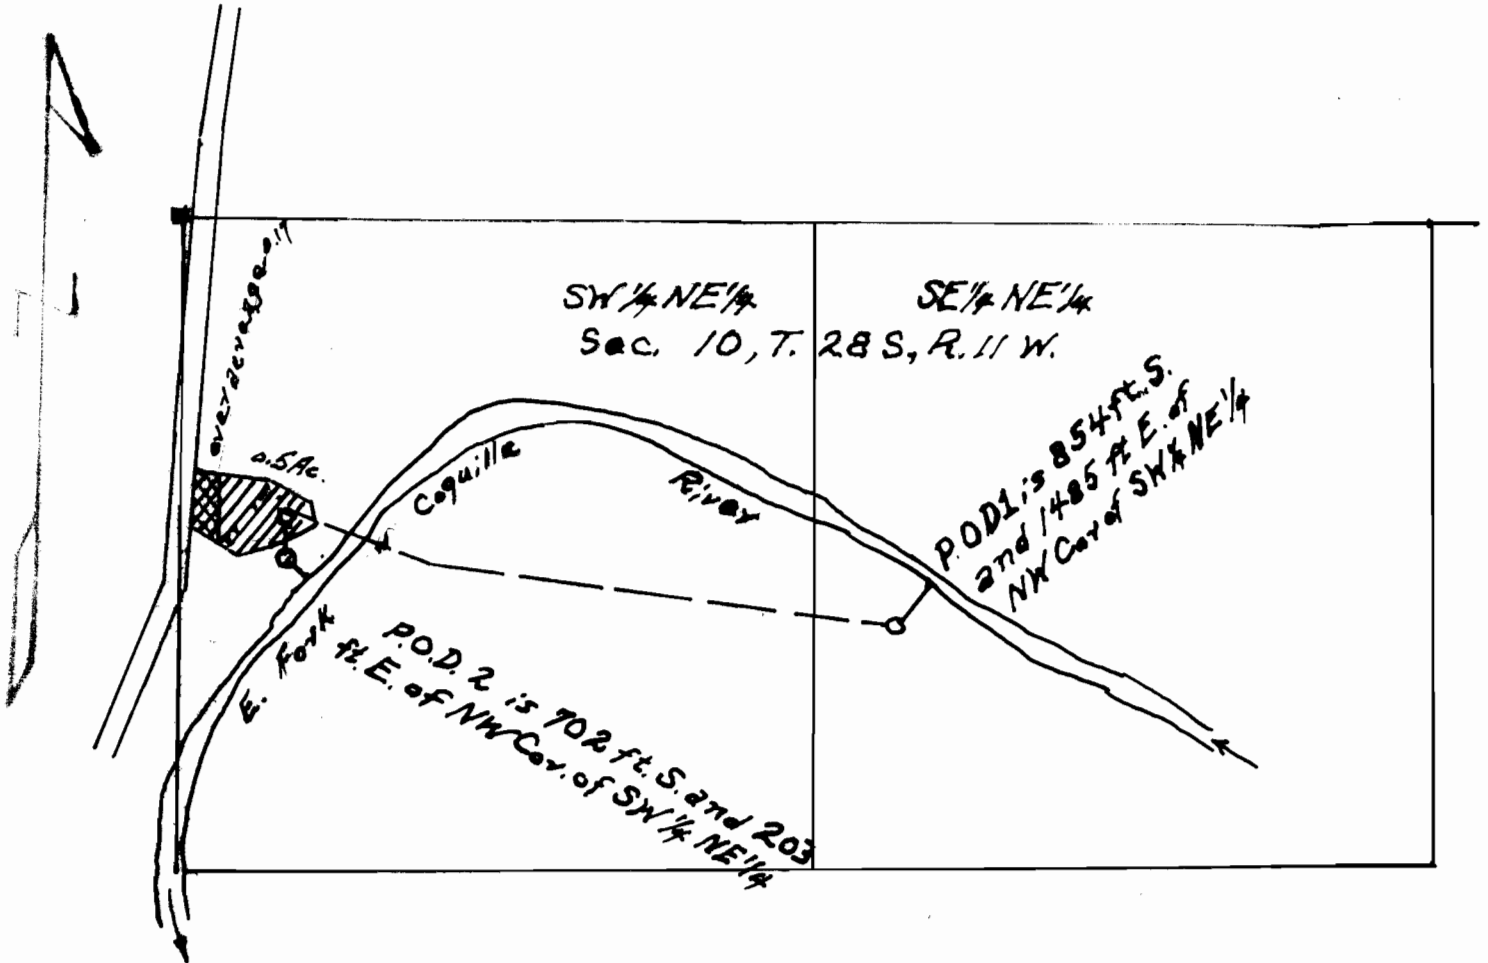

FINAL PROOF SURVEY
UNDER

Application No. 70510 Permit No. 51388

In Name of

Ted T. and Eloise A. Kirsch

Surveyed Nov. 5, 1992 by:

