


FINAL PROOF MAP

NW 1/4 NW 1/4, SEC. 26, T19S, R12W, W.M.
LANE COUNTY, OREGON

FOR: RICHARD K. SMITH
HARRIET G. SMITH
P.O. BOX 1717
FLORENCE, OR 97439

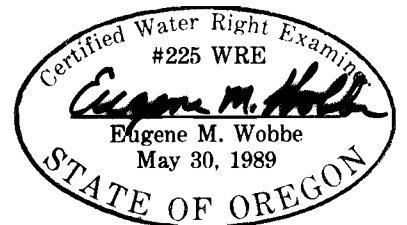

PREPARED BY: WOBBE & ASSOCIATES, INC.
510 KINGWOOD ST./P.O. BOX 1136
FLORENCE, OR 97439

SCALE
1" = 400'