

T.6 S., R.44 E., W.M. BAKER COUNTY

No. 71565

No.


NOTES:

THE SCALE OF THIS DRAWING AND THE DEPICTION OF THE BOUNDARY OF SECTION 33 ARE APPROXIMATE, DUE TO UNUSUAL DISTORTION IN THE SECTIONAL SUBDIVISIONS. DIMENSIONING FOR POINTS OF DIVERSION AND USE WERE DETERMINED BY STAFF COMPASS AND STEEL TAPE TRAVERSE. TRAVERSE MEASUREMENTS WERE TAKEN BY THE APPLICANT.

FINAL PROOF SURVEY

PERMITTEE: EDWARD A. & CARMELITA M. HOLLAND
PERMIT 51415

THIS DRAWING CORRECTLY REPRESENTS THE SOURCE LOCATION AND AREA OF USE AND IS SUBMITTED TO ACCOMPANY THE CLAIM OF BENEFICIAL USE AND SITE REPORT FOR PERMIT 51415.

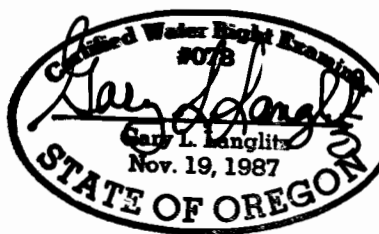

SCALE:
SCHEMATIC

REVISED JULY, 1993



APRIL, 1991

WATER RIGHT APPLICATION MAP

APPLICANT: ED AND CARMELITA HOLLAND
RT. 1 BOX 39
RICHLAND, OREGON 97870

FIGURE

1

J#2707-20

140595

SPRING #2
160' N AND 10' W
FROM SECTION
CORNER

TROUGH- POINT OF USE
20' S AND 280' W
FROM SECTION CORNER

FD. BRASS CAP
BAKER CO. SURVEYOR 1979

FD. BRASS CAP
BAKER CO. SURVEYOR
1979

SPRING #1
220' S AND 1080' E
FROM 1/4 CORNER 32/33

FD. BRASS CAP
"BLM 1988"

HOLLAND CABIN - POINT OF USE
110' S AND 80' WEST FROM
W 1/16 CORNER

SECTION 33

32 33
5 4

33 34 T6S
4 3 T7S R44E