

RECEIVED

APR 30 1993

WATER RESOURCES DEPT.
SALEM, OREGON


T4N, R5W, W.M.
COLUMBIA COUNTY, ORG.

SCALE 1" = 400'

FINAL PROOF MAP
UNDER

MICHAEL & ELLEN JOHNSON
PERMIT # 51345


NW 1/4 SECTION 12

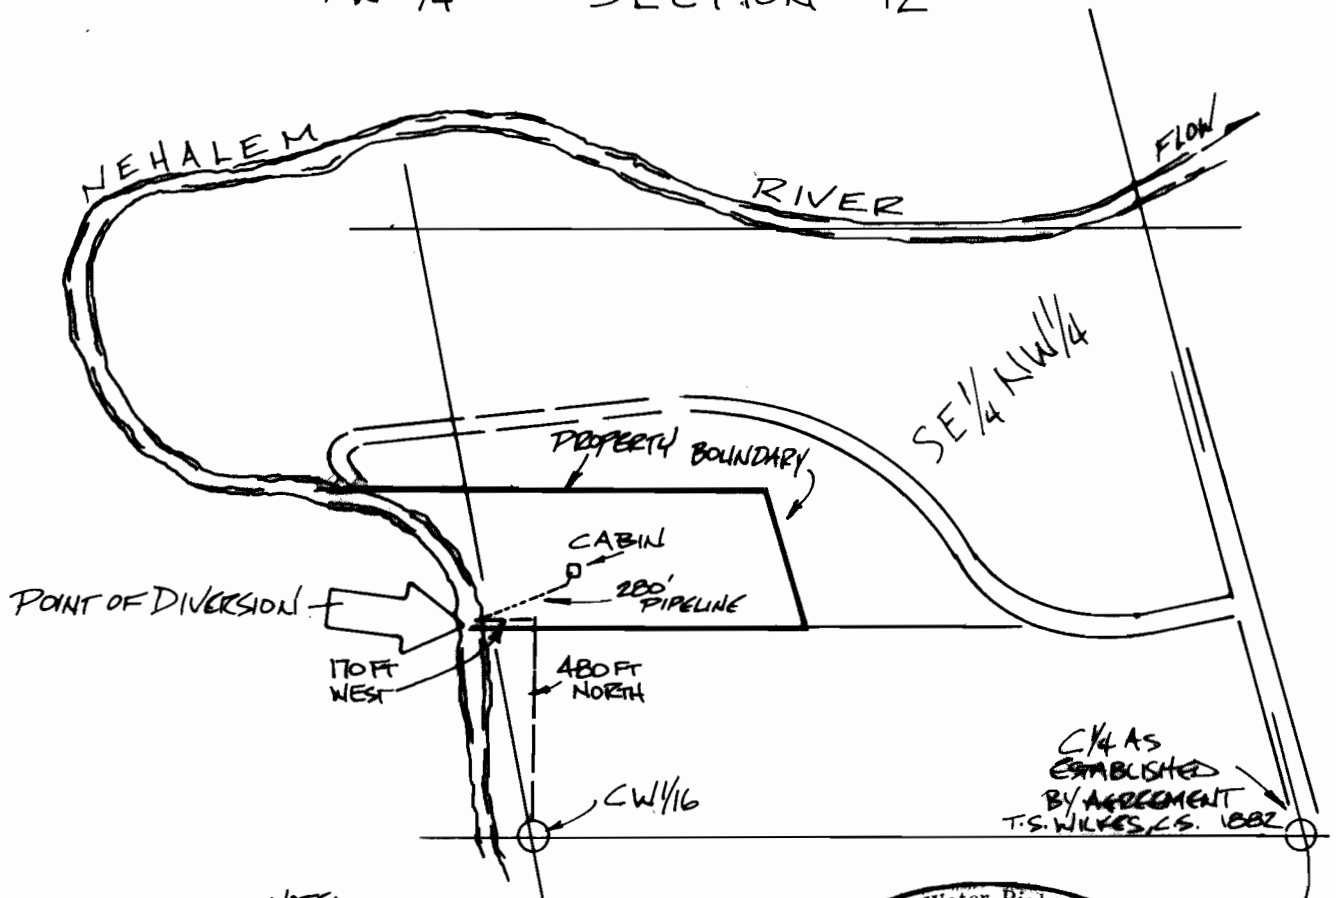

by: LG KEENON
1311 ALDER ST
VERNONIA, OR.
97064

PH 429-6115

NOTE:
THIS MAP IS FOR THE PURPOSE OF IDENTIFYING
THE LOCATION OF THE WATER RIGHT ONLY
AND IS NOT INTENDED TO PROVIDE
LEGAL DIMENSIONS OR LOCATION OF
PROPERTY OWNERSHIP LINES.

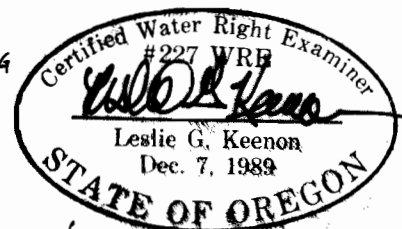

Nov. 25, 1992