

R. 26E. WM.
 R. 26E. WM.
 R. 26E. WM.

NOT TO SCALE

See large map file


T2N R26E W.M.

SABRE PHOTO 1-7 11-10
 PFS-1979-P-A

P.L.C.

T. 2N. R. 26E. W. M.

75848
52085
L4190
72774

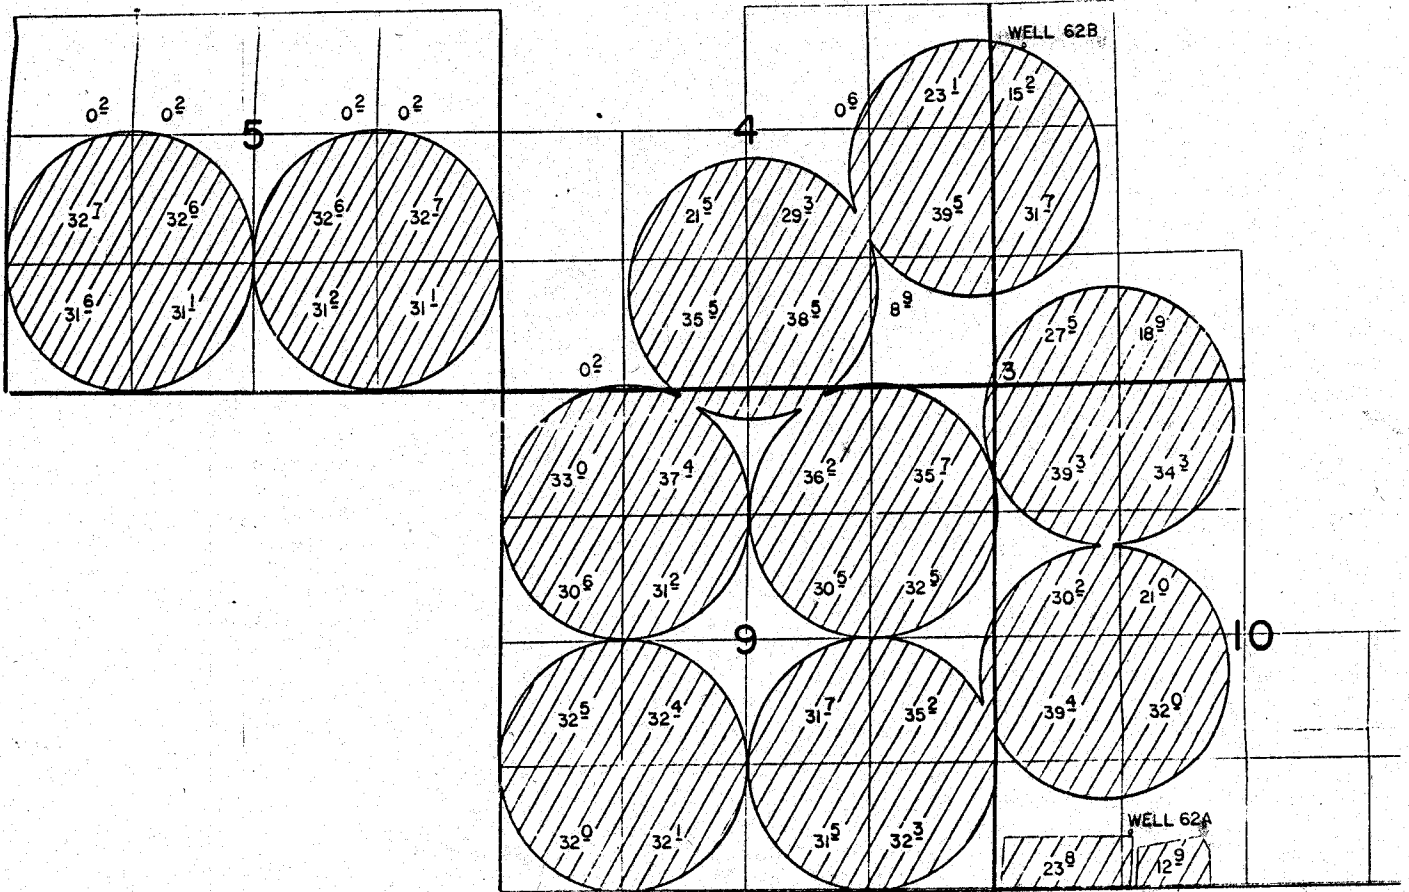

WELL 62B LOCATED 350'N & 350'E FROM SW COR SEC 3 T.2N., R.26E. W.M.
 WELL 62A LOCATED 560'N & 1450'E FROM SW COR SEC 10 T.2N., R.26E. W.M.
 WELL 62 LOCATED 3700'S & 1790'E FROM NW COR SEC 23 T.2N., R.26E. W.M.

FINAL PROOF SURVEY
 UNDER

APPL. NO. G-5096

PER. NO. G-4918

IN NAME OF

CONNECTICUT GEN. LIFE INS. CO.

SURVEYED MAY 3, 1979 by R. BARWIN

NOT TO SCALE

*So large.
 map full*