



R. 31 E.

I, L. E. Lucas, of John Day, Oregon do hereby certify that this map was made from notes taken during an actual survey by me on July 7, 1924, and that it correctly represents the works described in the accompanying application, together with the location of streams and other ditches in the immediate vicinity, and has written thereon the area in each smallest legal subdivision which it is proposed to serve.

L. E. Lucas
Civil Engineer


Appropriator.

Scale 1 in. = 400 Ft.

SEE ALSO MAP
PLAT 20 OF P. 1217

7274
7280
Per Map 7306
7307

3
45
7306
7307

Sec 12
356.74
356.13

355° 28' W 103.91'

4640.6 Ft.
2583.2 Ft.

20m


Yancey Cr.
1 inch Pipe Line
1356.27' 40 Ft. Road

N 27° 27' W

Bear Gulch

3 inch Pipe Line
40 Ft. Road

Point

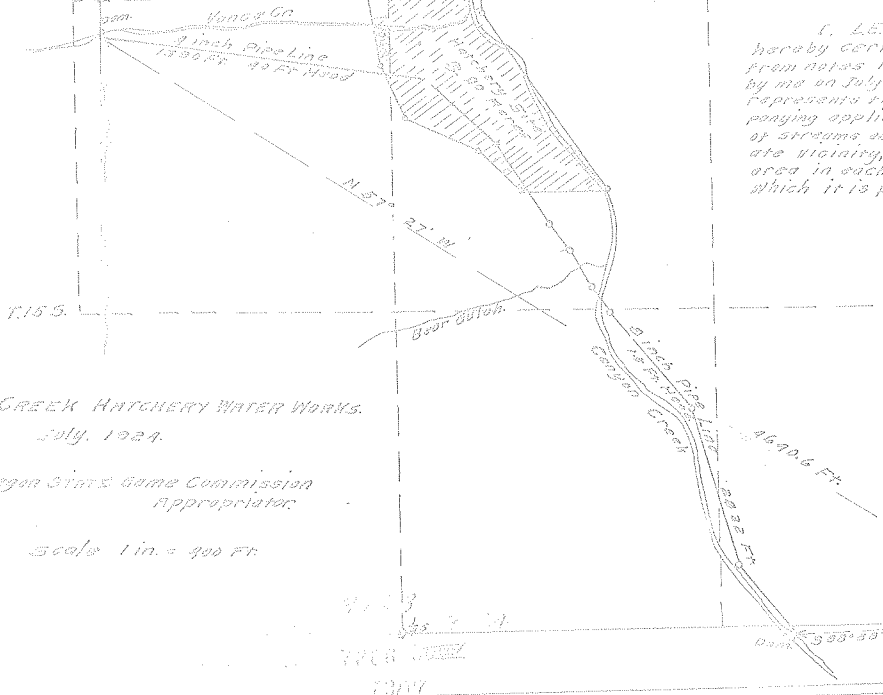

I, L. E. LUCAS,
 hereby certify that the
 from notes taken
 by me on July 7, 1924
 represents the water
 paying application
 of streams and affluents
 in the vicinity, and the
 area in each section
 which it is proposed

CANYON CREEK HATCHERY WATER WORKS.

July, 1924.

OREGON STATE Game Commission
 Appropriator.

Scale 1 in. = 400 Ft.

9723
 7718
 7307

9723 9718 7307

Dam N 55° 55' W 4640.6 Ft