
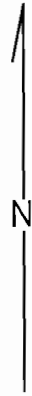


T18S. R45E., W.M.

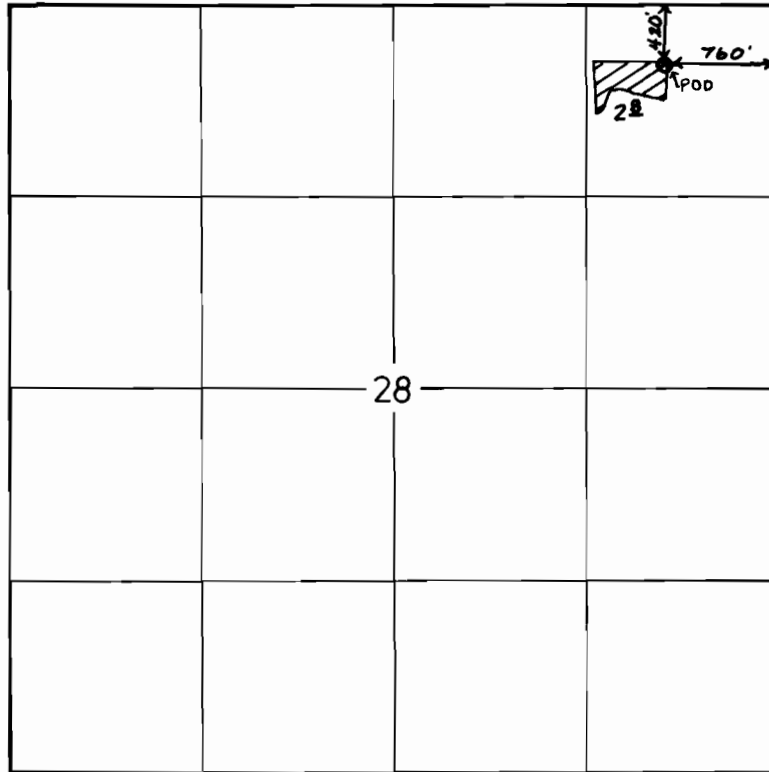

1" = 1320'

**FINAL PROOF SURVEY**  
UNDER

Application No. G-11073. Permit No. G.10228....  
**IN NAME OF**

.....DARRELL D. WHEELER.....

Surveyed 4-16.... 1986., by L. TOLL.....