


R-11365
2 72936

"= 400'

1285 K15E
SECTION 29

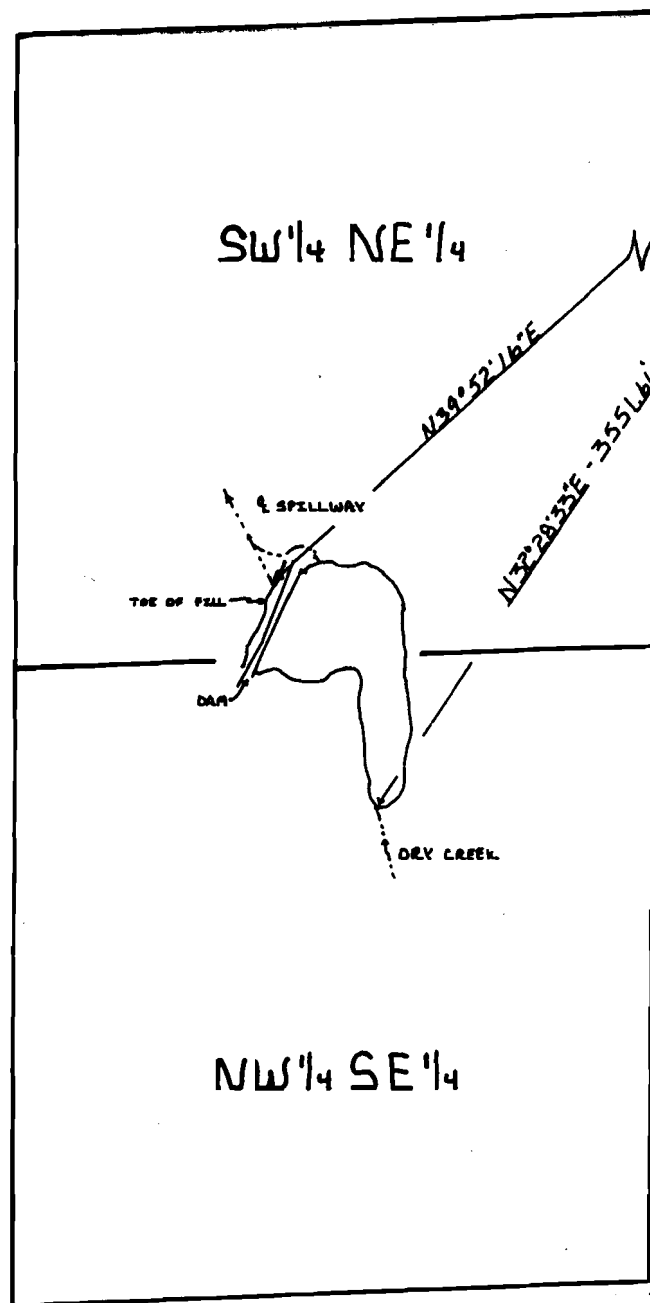

20 | 21
29 | 28

LAKE COUNTY
SURVEYOR DESS
CAP

FINAL PROOF MAP
ROYAL CROWN CATTLE COMPANY, INC.
BRUCE EMERY, PRESIDENT
APPLICATION # R-70264 PERMIT # R-11365
APPLICATION # 70267 PERMIT # 51207


SURVEYED - SEPT. 10, 1992
ACRE FEET STORED - 2.9
SURFACE AREA - 1.8 ACRES
MAXIMUM DEPTH - 4'

RECEIVED

WATER RESOURCES DEPT
SALEM, OREGON

RECEIVED

AUG 21 1996
WATER RESOURCES DEPT.
SALEM, OREGON

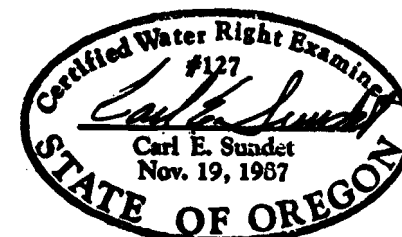

THIS MAP IS FOR THE PURPOSE OF
IDENTIFYING THE LOCATION OF THE
WATER RIGHT ONLY AND IS NOT INTENDED
TO PROVIDE LEGAL DIMENSIONS OR
LOCATION OF PROPERTY OWNERSHIP
LINES

DRAWING # WR 4492
SEPT. 16, 1992