

T28S R15E

SECTION 29

FINAL PROOF MAP
ROYAL CROWN CATTLE COMPANY, INC.

BRUCE EMERY, PRESIDENT

APPLICATION # R-70264 PERMIT # R-11365

APPLICATION # 70267 PERMIT # 51207

SURVEYED ~ SEPT. 10, 1992

ACRE FEET STORED ~ 2.9

SURFACE AREA - 1.8 ACRES

MAXIMUM DEPTH ~ 4'

SALEM, OREGON

RECEIVED

AUG 21 1996


WATER RESOURCES DEPT
SALEM, OREGON



THIS MAP IS FOR THE PURPOSE OF
IDENTIFYING THE LOCATION OF THE
WATER RIGHT ONLY AND IS NOT INTENDED
TO PROVIDE LEGAL DIMENSIONS OR
LOCATION OF PROPERTY OWNERSHIP
LINES

DRAWING # WR 4492 100
SEPT. 16, 1992
APPROVED 3-29-93

20 21
29 28
LAKE COUNTY
SURVEYOR DEPT
MAP

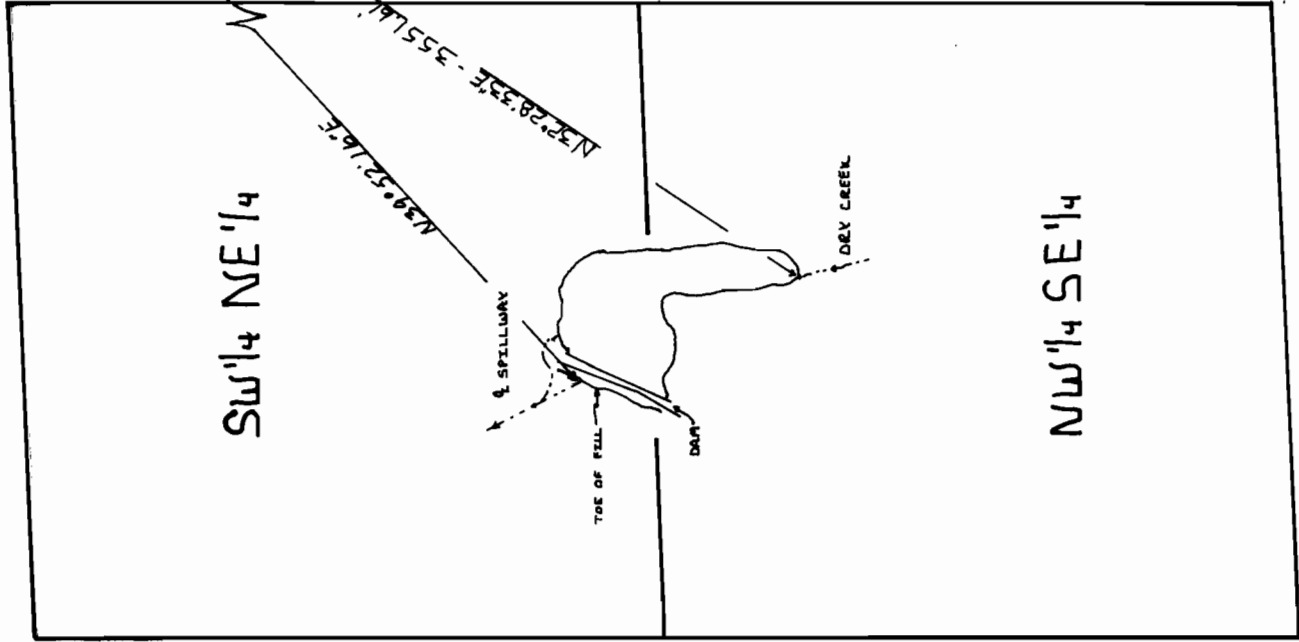

1" = 400'