


SECTION 6, TWP.2 N. RANGE 12 E. W.M.
 WASCO COUNTY, OREGON

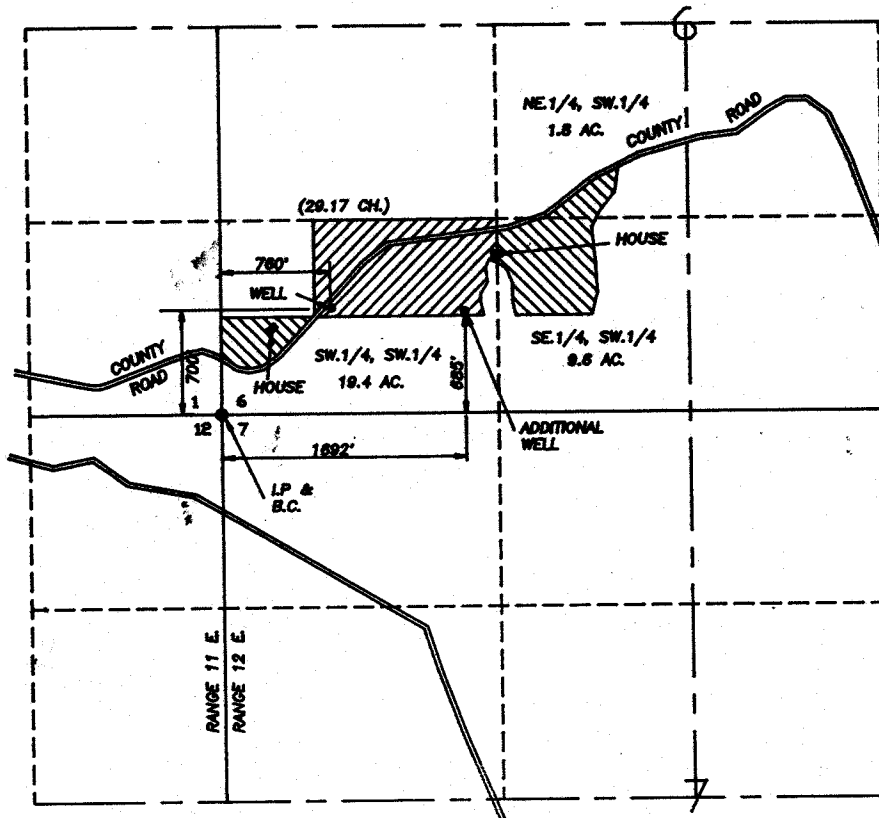

FINAL PROOF SURVEY

SCALE: 1" = 1320'

CERTIFICATE No. 55637

PERMIT No. G-7115

TRANSFER FILE No. T-6082


IN THE NAME OF:

ANITA BYRD GANNON, DBA, BYRD ORCHARDS

DATE: SEPTEMBER 30, 1992

REVISED MARCH 15, 1993.

BY: TENNESON ENGINEERING CORP.
 409 LINCOLN STREET,
 THE DALLES, OREGON. 97058
 PH. (503) 296-9177
 FAX (503) 296-6657

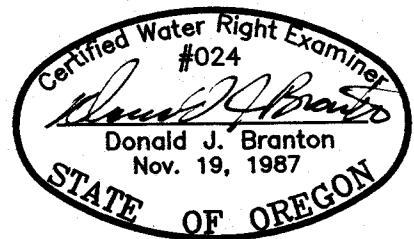

NOTE:

'THIS MAP IDENTIFIES THE LOCATION OF THE WATER RIGHT ONLY AND IS NOT INTENDED TO PROVIDE DIMENSIONS OR LOCATE PROPERTY OWNERSHIP LINES.

W.O. #7014