T. 2N., R. 32E., W. M.

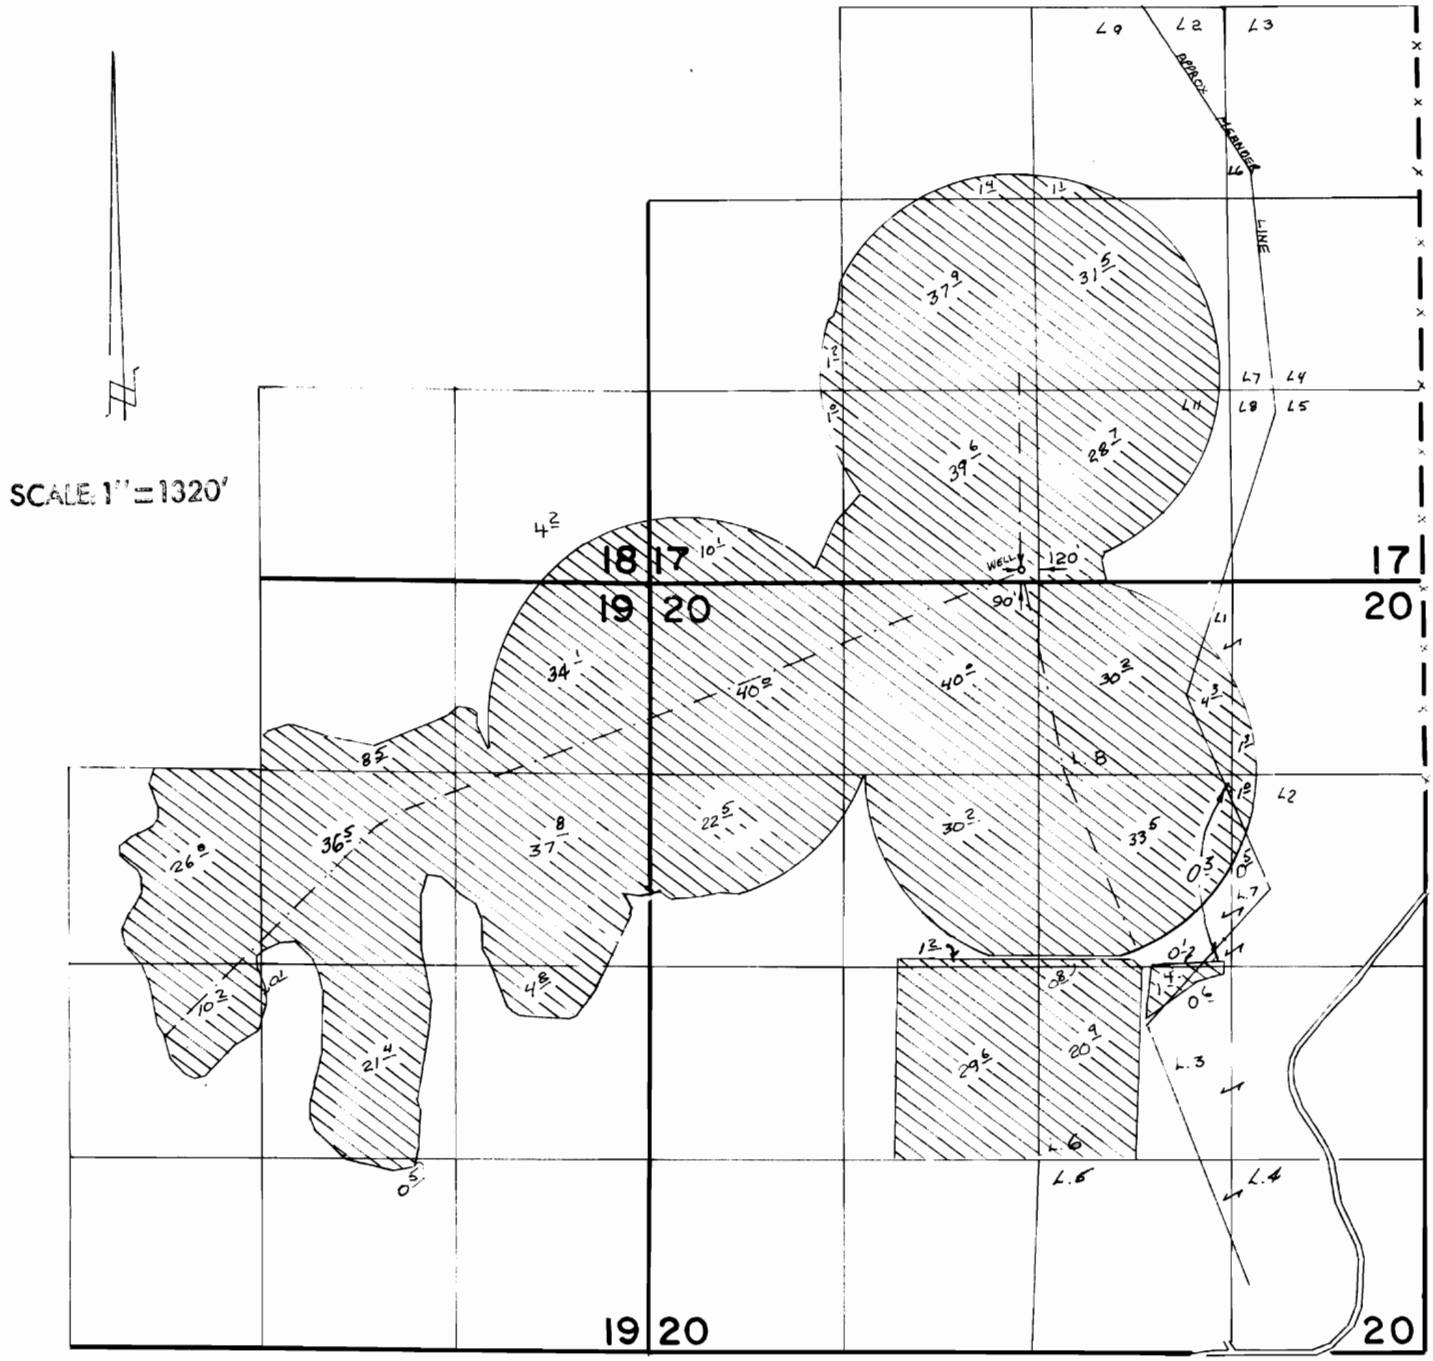

FINAL PROOF SURVEY

UNDER

Application No. G-9114 Permit No. G-8483

IN NAME OF

RUSSELL R. & BERNICE A. KULM, DARRELL L. & KATE KASSENS

Surveyed 12-18 19 84, by V. L. Church

738 JKS