T.6S. R.1W. W.M.

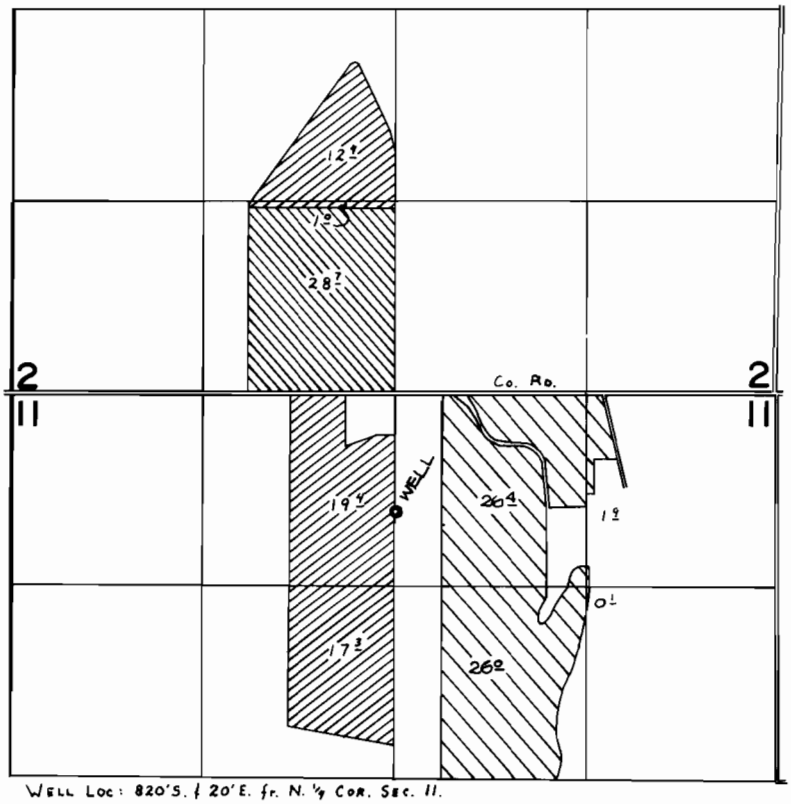

WELL LOC: 820'S. & 20'E. fr. N. 1/4 COR. SEC. 11.

- PRIMARY IRR.
- SUPPLEMENTAL TO GR CERT. 168.
- SUPPLEMENTAL TO CERT. 30707

FINAL PROOF SURVEY
UNDER

Application No. G-7883 Permit No. G-7296
IN NAME OF

ROBERT A. DUDA & DICKMAN FARMS, INC.

Surveyed July 9 19 80, by C. L. Hughes

DFN-3LL-176